
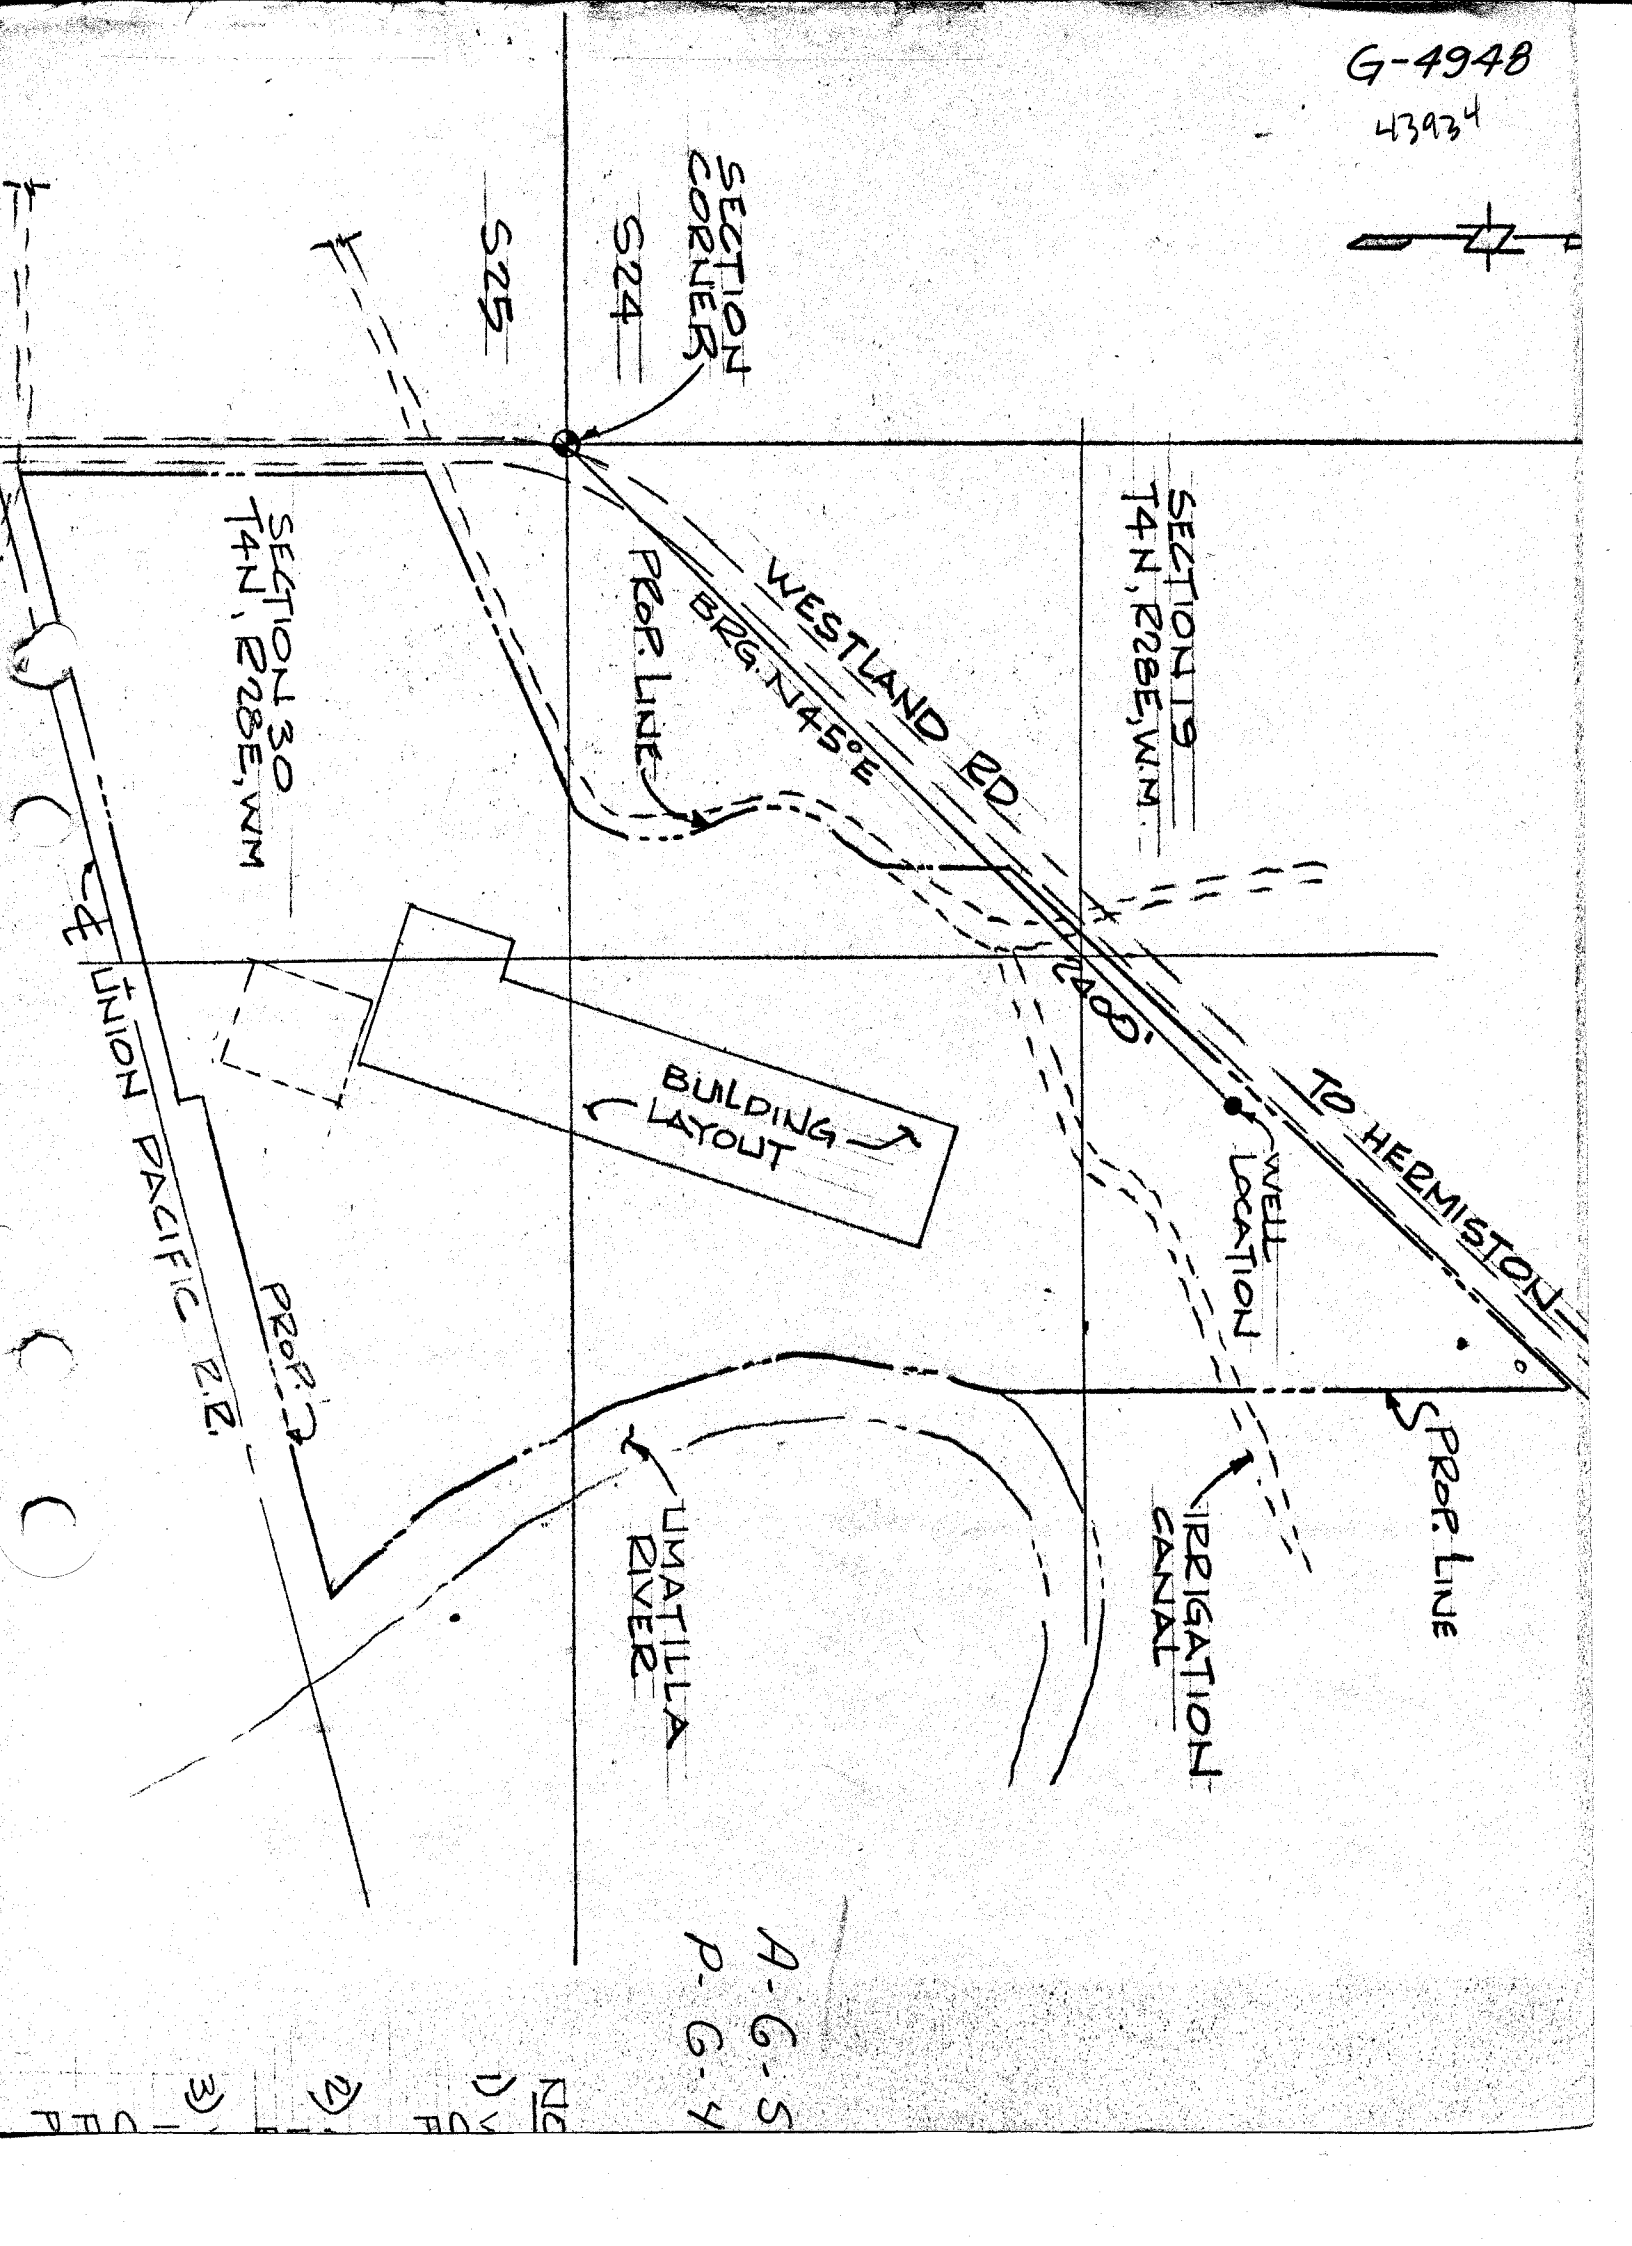


G-4948

43934

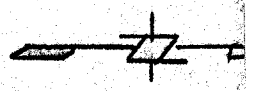

SECTION CORNER

S25

S24

SECTION 19  
T4N, R28E, W1M

SECTION 30  
T4N, R28E, W1M

WESTLAND RD  
Brg. N45°E

PROP. LINES

UNION PACIFIC R.R.

BUILDING LAYOUT

TO HERMISTON

WELL LOCATION

PROP. LINE

IRRIGATION CANAL

UMATILLA RIVER

PROP. L.

A-G-S  
P-G-Y

ND  
D  
3