


T.4S.R.11E.W.M.

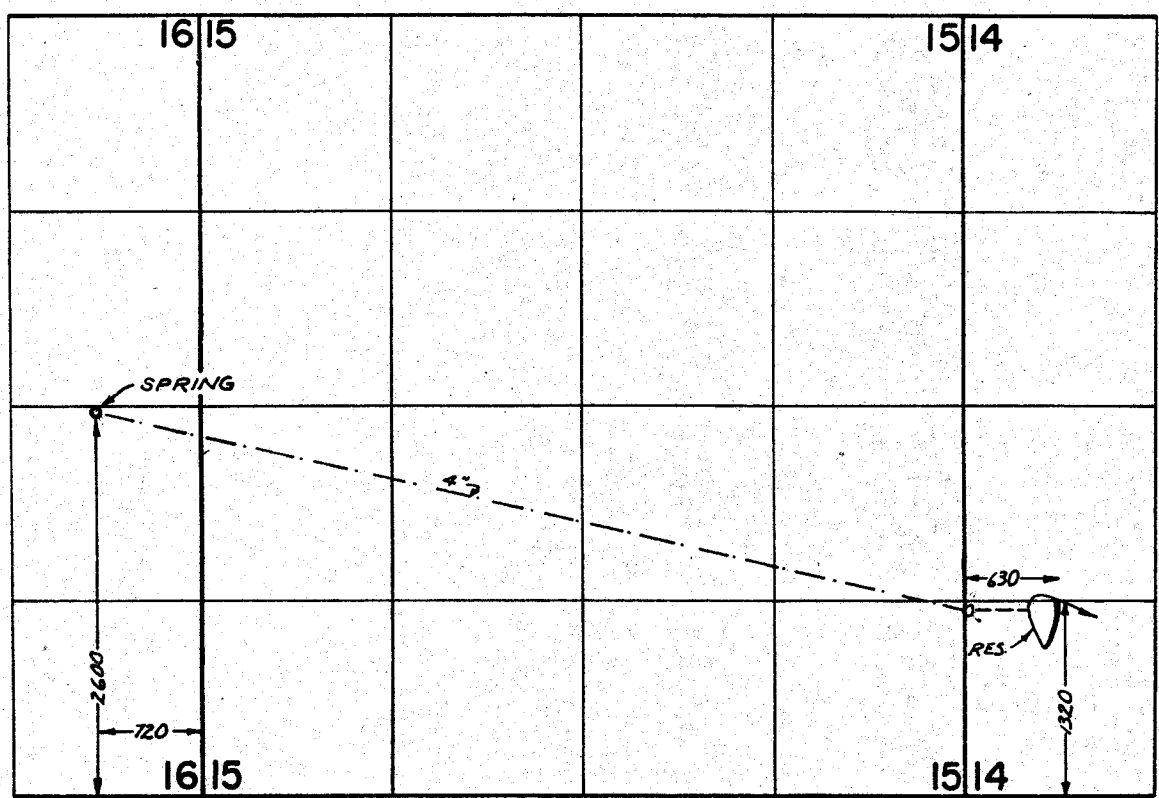

SPRING LOC. FROM APPLICANTS MAP

FINAL PROOF SURVEY UNDER

Application No. ^{R-45324} ~~45245~~ Permit No. ^{R-5351} ~~33798~~
IN NAME OF

E. R. SMART

Surveyed SEPT. 12, 1974, by D. NORBY