


# T.4S.R.11E.W.M.

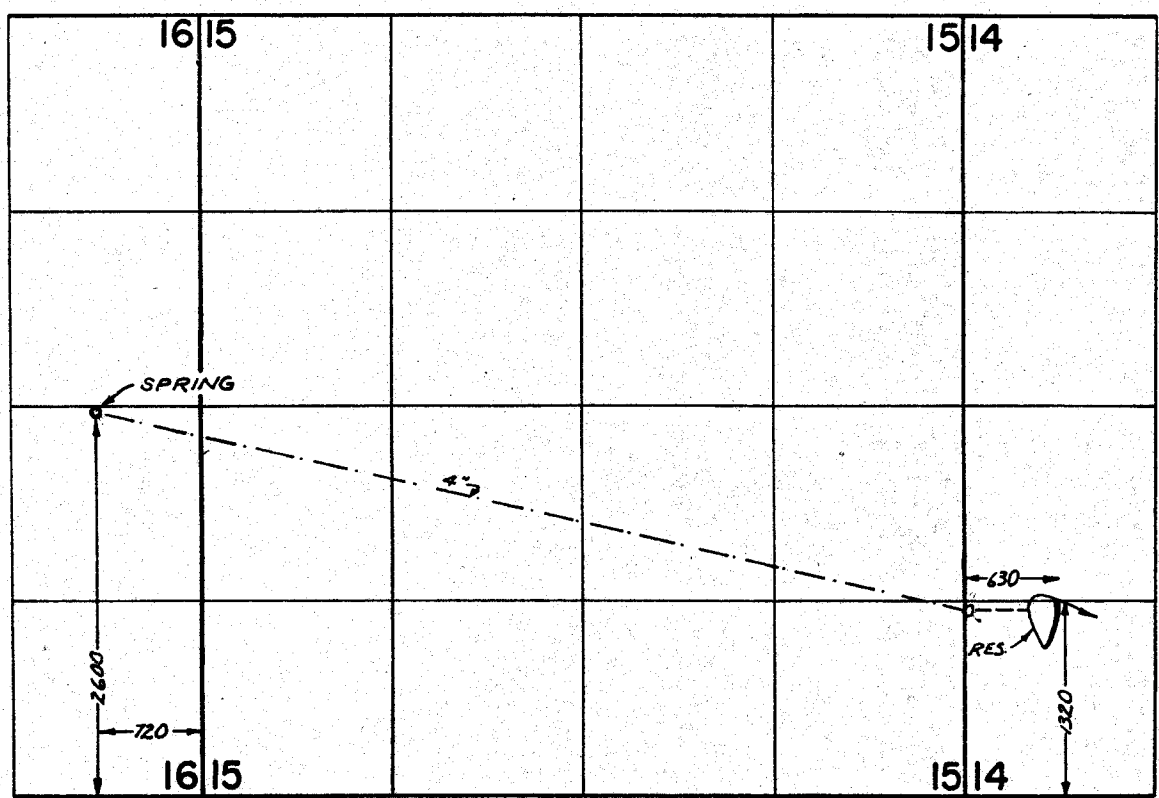

SPRING LOC. FROM APPLICANTS MAP

## FINAL PROOF SURVEY UNDER

Application No. R-45324 45245 Permit No. R-5351 33798  
IN NAME OF

E. R. SMART

Surveyed SEPT. 12, 1974, by D. NORBY