


T. 1S. R. 2W. W.M.

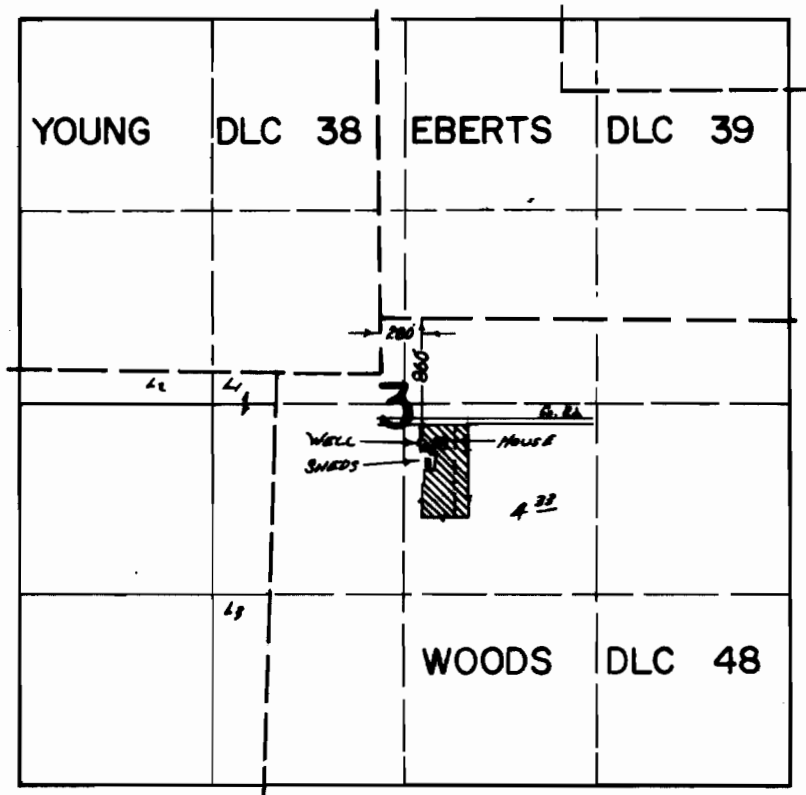

FINAL PROOF SURVEY
UNDER

Application No. G-5858. Permit No. G-5036.
IN NAME OF

...WILLIAM F SANDERS SR.

Surveyed July 26 1974, by R. G. MUCKEN