


T.1S. R.3&4W. W.M.

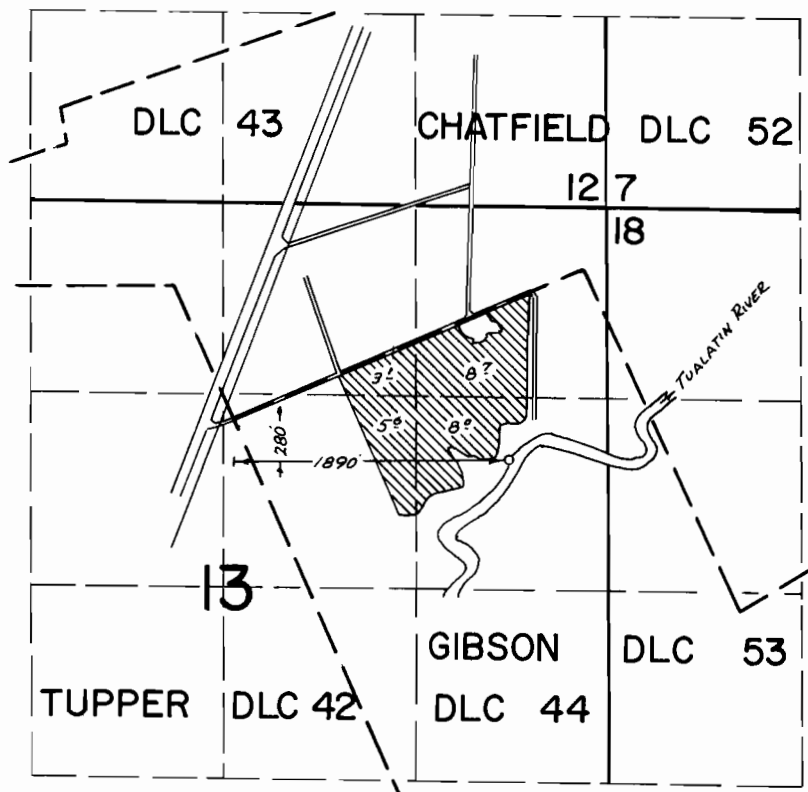

**FINAL PROOF SURVEY**  
UNDER

Application No. 47027... Permit No. 35179...  
IN NAME OF

CASEY E. NUTSCH

Surveyed Sep... 6... 1974, by R. G. MUCKEN