




T.1N. R.3W. W.M.

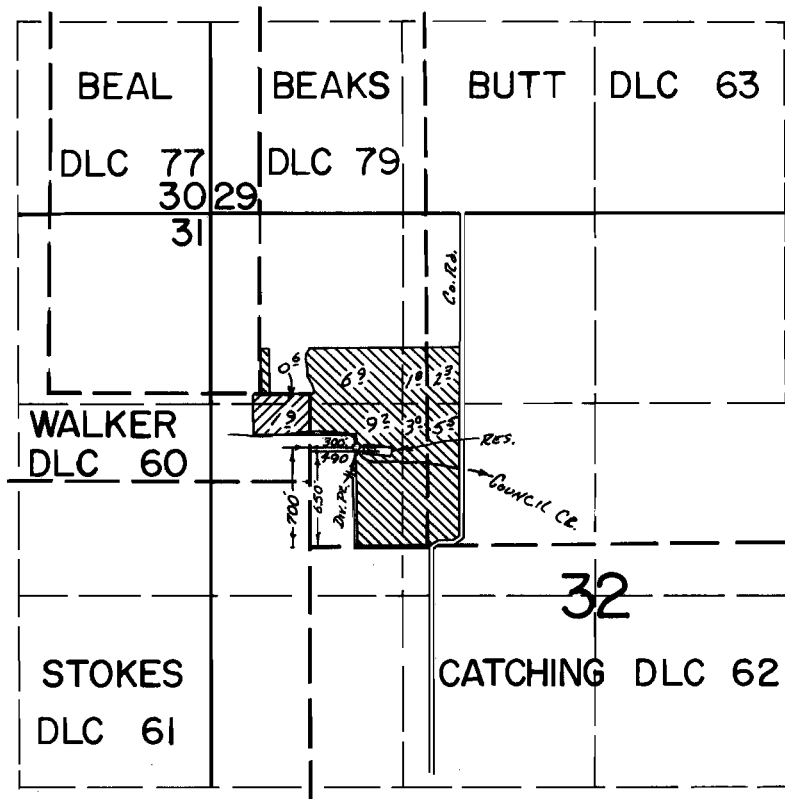

 *Primary*
 *Supplemental*

FINAL PROOF SURVEY UNDER

R-47773 R-5769
 Application No. ...47774. Permit No. ...35780.
 IN NAME OF

.....SYLVESTER VAN LOO.....

Surveyed April... 1974, by R. G. MUCKEN