


T.8S.,R.23&24E.,W.M..

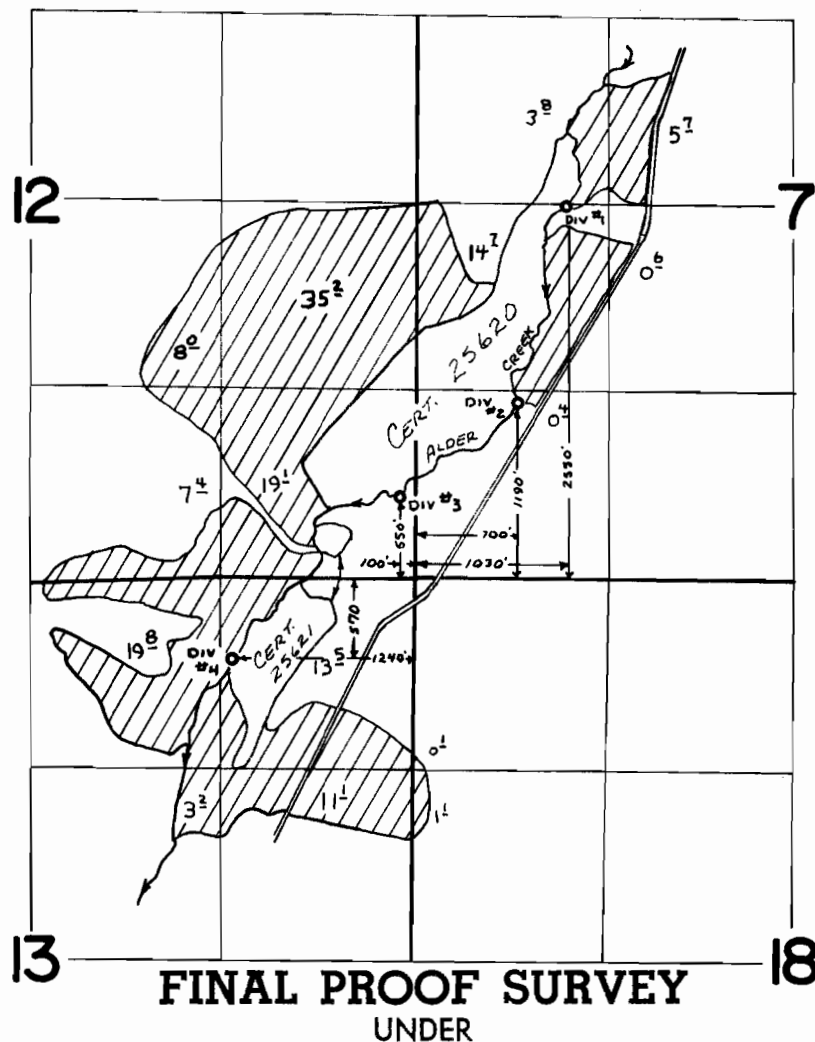

Transfer No. N-36
N-39

Application No. ~~43499~~ Permit No. ~~32537~~
IN NAME OF

VICTOR B. NASH

Surveyed Aug. 6 1974, by L. H. Nunn
JUNE 6 1975 L. Toll