


T.5S.,R.3W.,W.M.

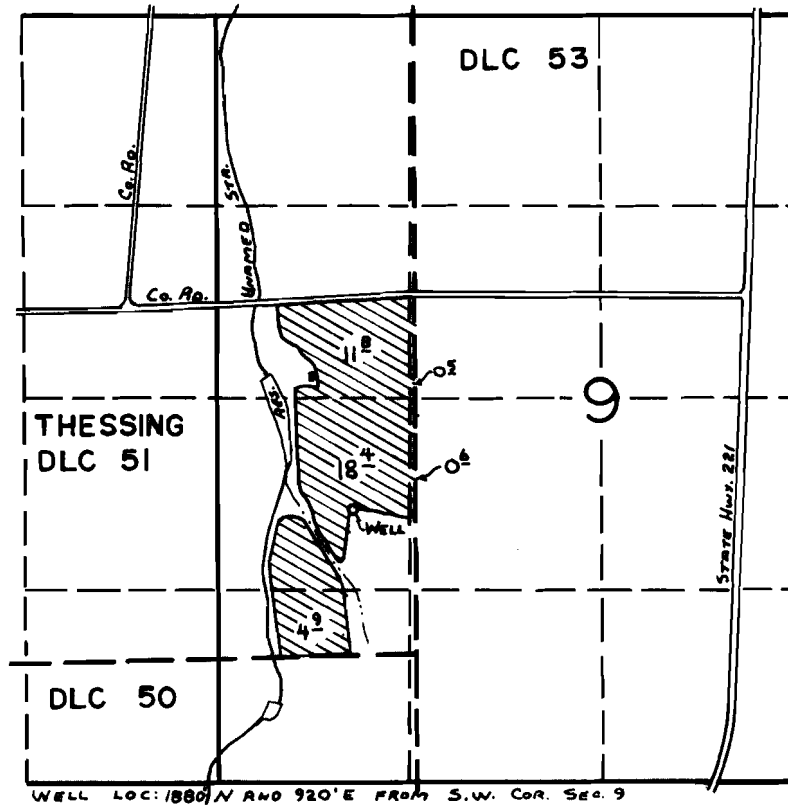

FINAL PROOF SURVEY
UNDER

Application No. G-5132 Permit No. G-4868
IN NAME OF

JOE AND CARL HOLBROOK

Surveyed JUNE 14 1974, by L. TOLL