


T.5&6S. R.7W. W.M.

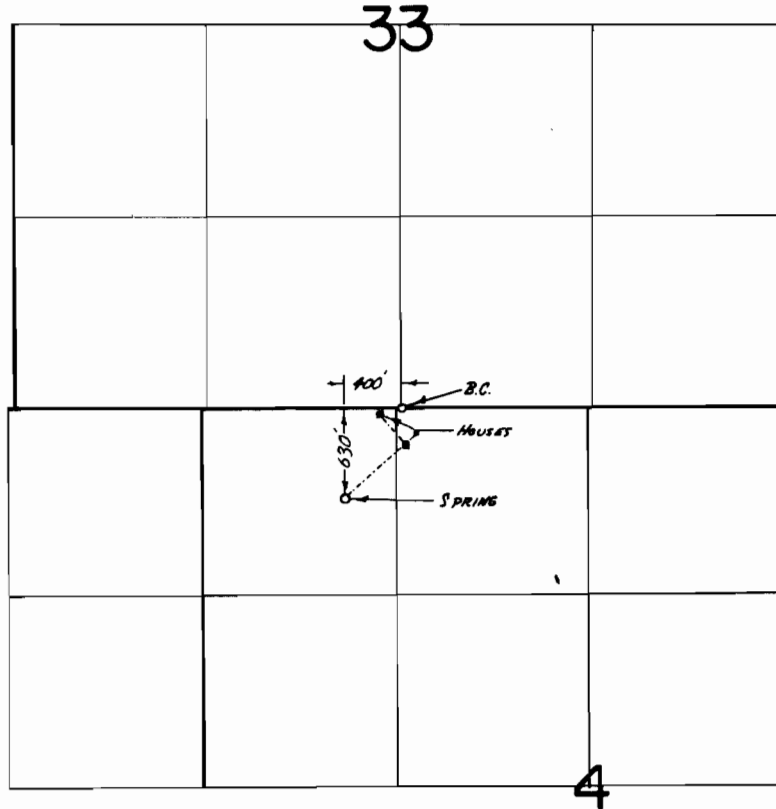

FINAL PROOF SURVEY
UNDER

Application No. 41169... Permit No. 30689...
IN NAME OF

ETHEL RYDELL & HILDING RYDELL

Surveyed Oct...8... 1974, by T...J...PAUL....