


T.13S.R.5W.W.M.

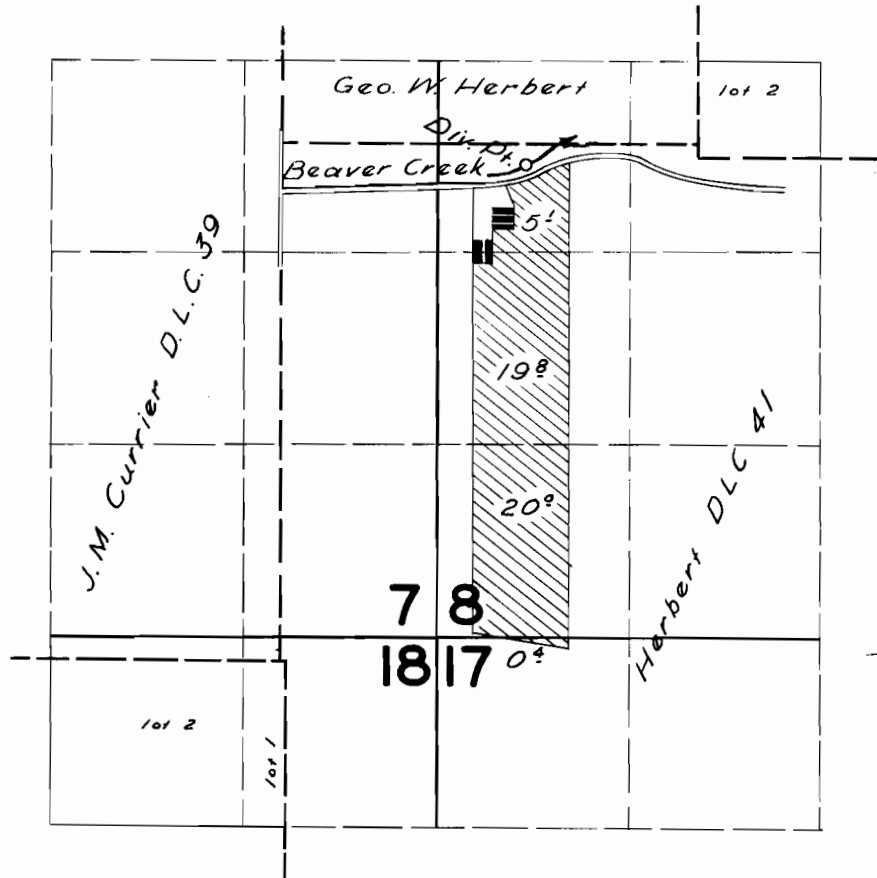

FINAL PROOF SURVEY
UNDER

Application No. 26592 Permit No. 20829
IN NAME OF

Morse M. Smith

Surveyed 6 Sept. 1957, by *[Signature]*