


Section 25, T14S, R6W, W.M.,
Benton County, Oregon

Certificates 43952 and 60462
Peggy Goracke

RECEIVED
MAR 27 2019
OWRD

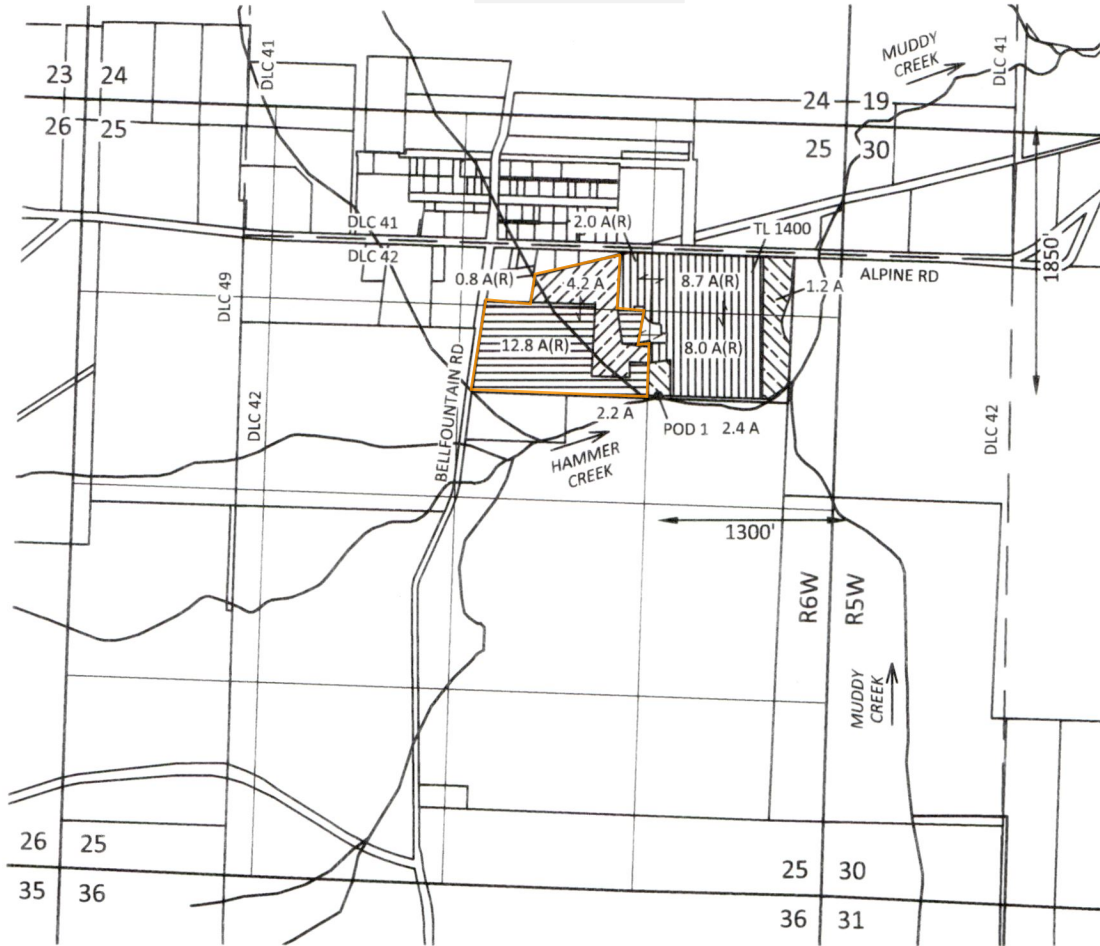


EXPLANATION

FROM LANDS

-  CERTIFICATE 43952
PRIORITY: 4/20/1932
6.4 ACRES
-  CERTIFICATE 60462
PRIORITY: 7/7/1976
3.6 ACRES

REMAINING LANDS

-  CERTIFICATE 43952
PRIORITY: 4/20/1932
13.6 ACRES
-  CERTIFICATE 60462
PRIORITY: 7/7/1976
18.7 ACRES

• POINT OF DIVERSION (POD)

SCALE



1 INCH = 1320 FEET

March 19, 2019

This map is not intended to provide legal
dimensions or locations of property
ownership lines

Figure 1

SKOOKUM
WATER ASSOCIATES INC

1626 VICTORIAN WAY
EUGENE, OR 97401
(503) 319-8926