


T-5886 is Adding additional  
(V.41, p. 79)

P.O.D for 27<sup>0</sup> in NE SE Sec 25

T.2N., R.10E., W.M.

Additional P.O.D. is EFID  
P.O.D.

LMT  
W43

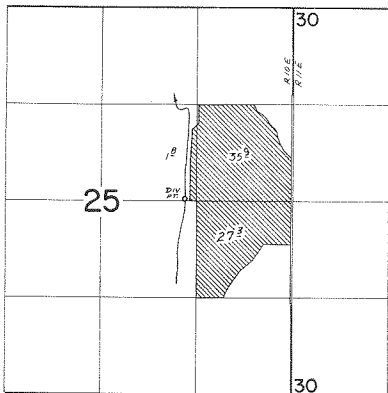

27<sup>0</sup> acres was  
part of C. 43959  
(priority 1871).

DIV. PT. LOC: 30' N $\frac{1}{2}$  160' W FROM SE COR. SW $\frac{1}{4}$  NE $\frac{1}{4}$  SEC. 25

**FINAL PROOF SURVEY**  
UNDER

Transfer No. T-65

Application No. .... Permit No. ....

IN NAME OF

TALLMAN ORCHARDS

Surveyed April 15 1975, by D. Norby