


T.35S., R.4W., W.M.

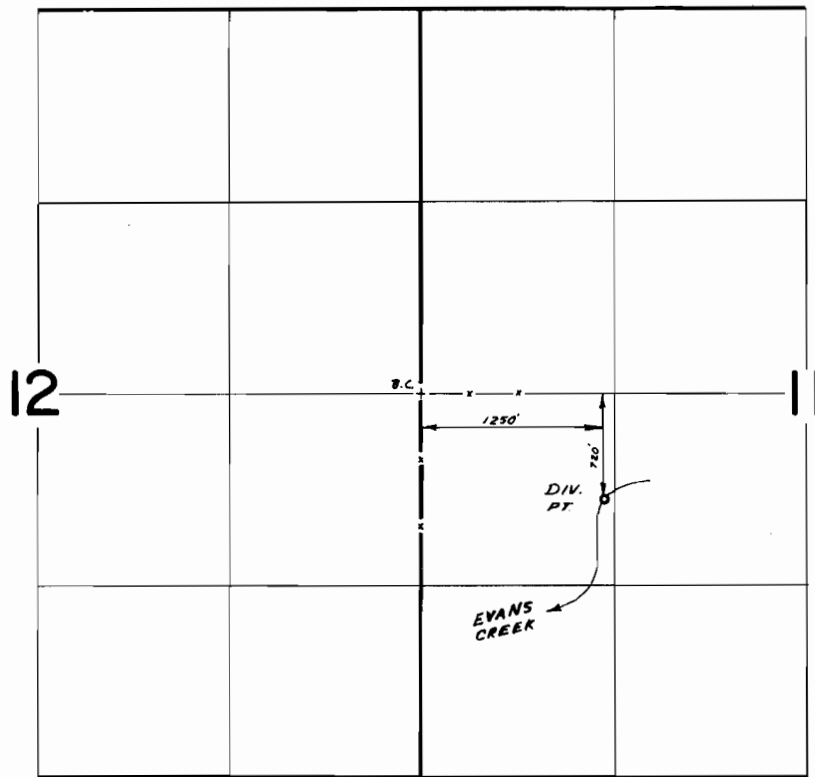

**FINAL PROOF SURVEY**  
UNDER

Transfer No. W-146 & W-147  
Application No. .... Permit No. ....  
IN NAME OF

HARRY E. AND NORLENE WARDLE

Surveyed May 6 1975, by D. Norby