


T.35S.R.3 W.W.M.

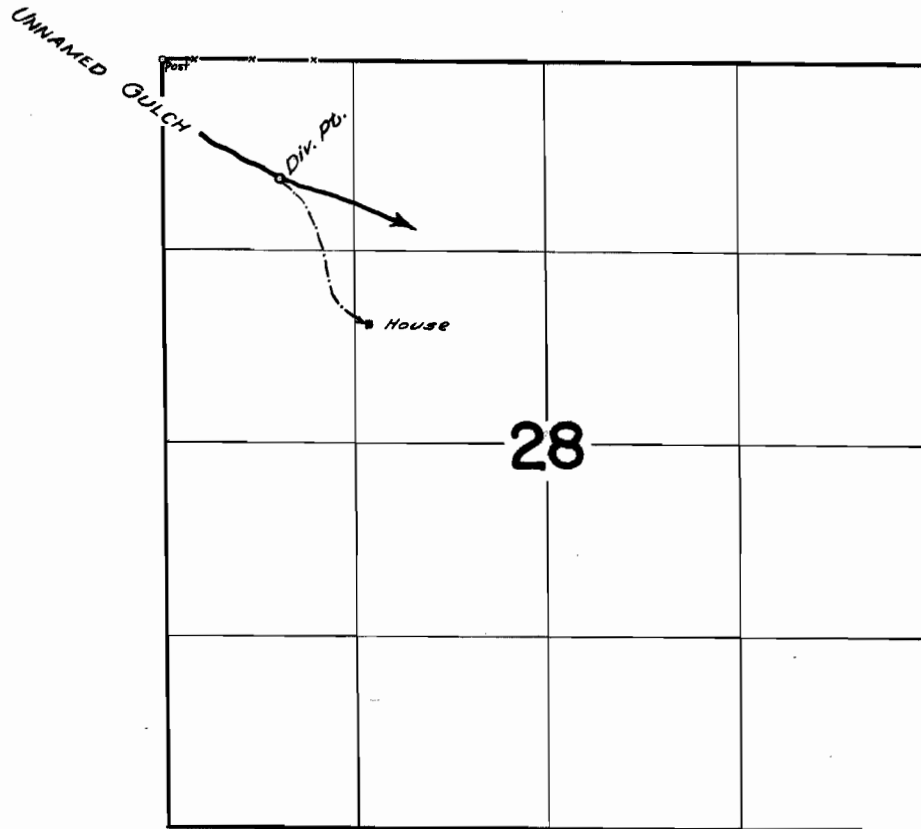

**FINAL PROOF SURVEY**  
UNDER

Application No. 33503... Permit No. 26500...  
IN NAME OF

OLAV K. LOKKEN

Surveyed *May 18*, 1963., by *R. Jackson*