


T.38S.R.3W.W.M.

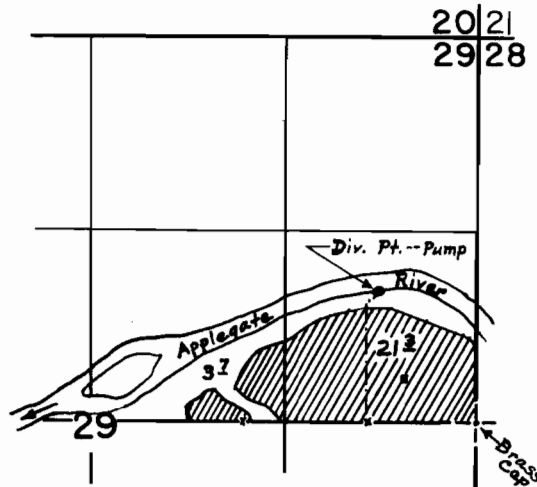

Diversion Point is located 900' N. &
670' W. from the E 1/4 Cor. Sec. 29.

FINAL PROOF SURVEY
UNDER

RECEIVED

JUN 14 1976

WATER RESOURCES DEPT
SALEM, OREGON

Transfer No. 3167

Application No. _____ Permit No. _____
IN NAME OF

Harlan P. & Marie Bosworth Jr.

Surveyed Mar. 4 1976, by D.C. Hendrix