


T.26 S.R.15 E.W.M.

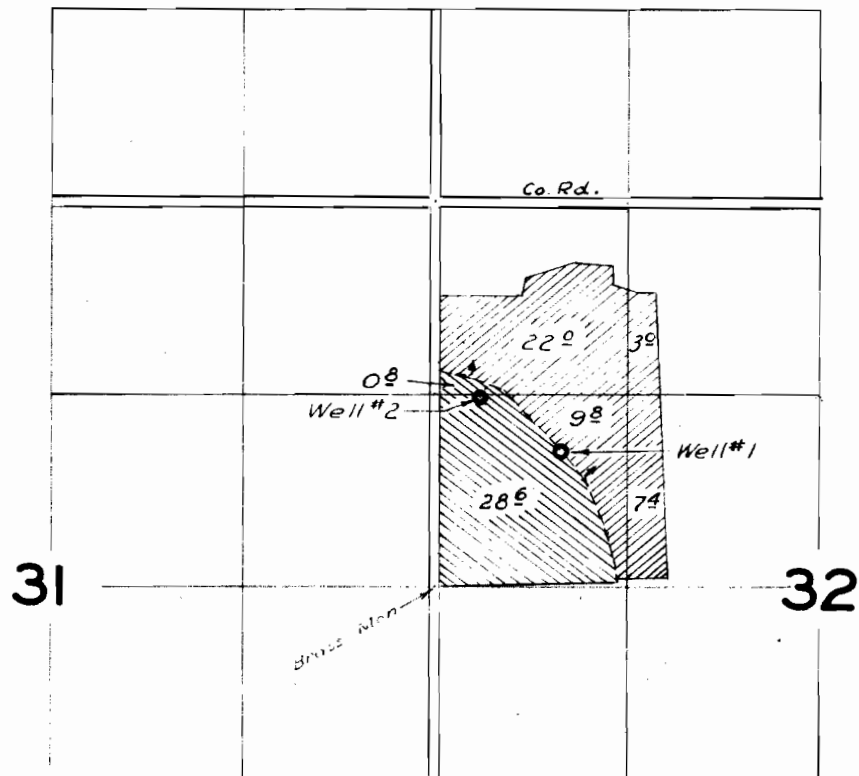

FINAL PROOF SURVEY
UNDER

Application No. *G-1292* *U-508* Permit No. *G-1136* *U-512* 
IN NAME OF

RICHARD SCHAUB

Surveyed *9 May* 1959, by *M. Rich*