


T. 17 S. R. 1 W. W. M.

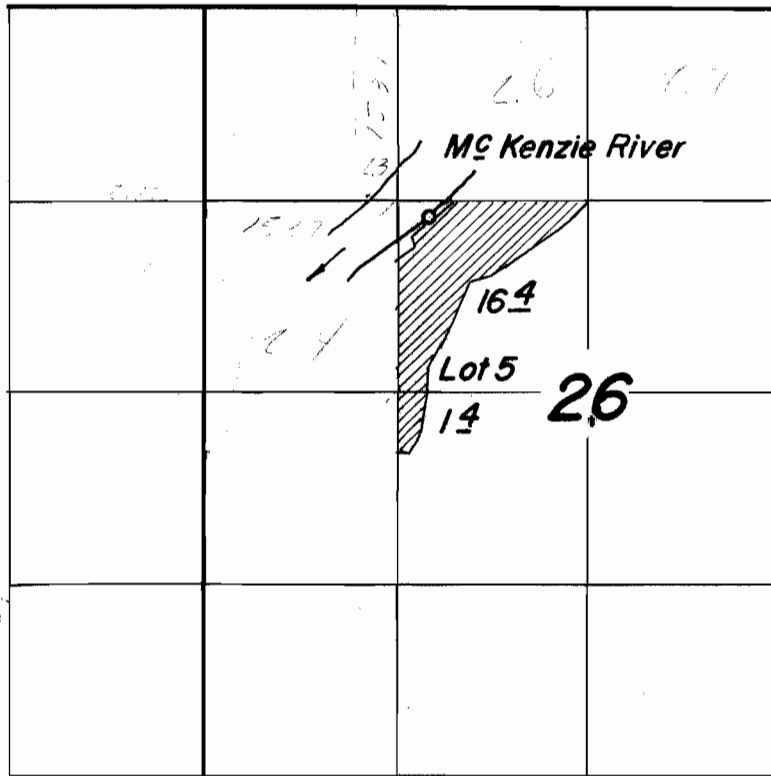


FINAL PROOF SURVEY
UNDER

Application No. 33277 Permit No. 26345
IN NAME OF


Surveyed June 18, 1963, by C. Baker

T. 17 S. R. 1 W. W. M.

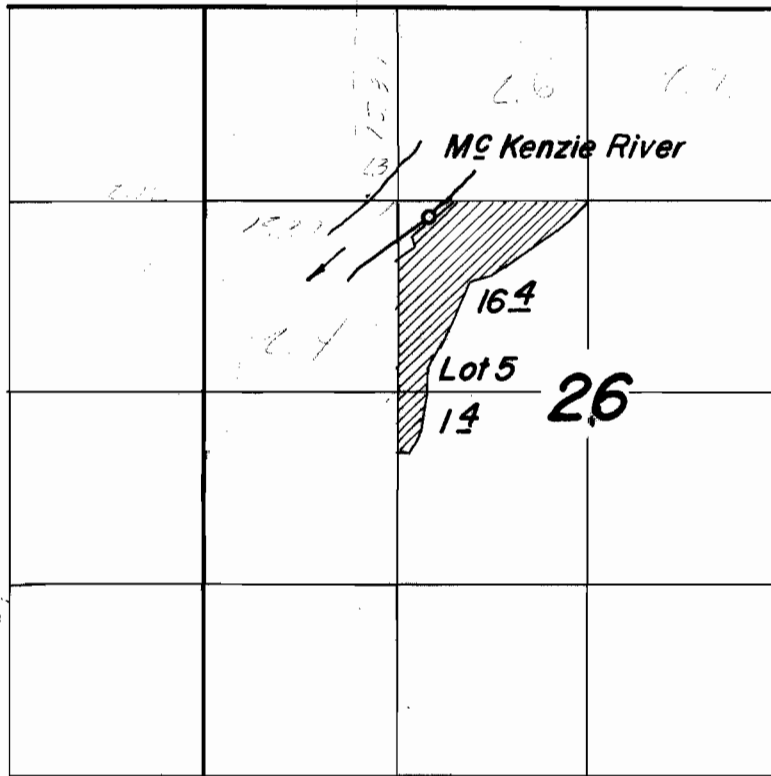

FINAL PROOF SURVEY
UNDER

Application No. 33277 Permit No. 26345
IN NAME OF


Surveyed June 18, 1963, by C. Baker