


T. 10 S. R. 2 W. W. M.

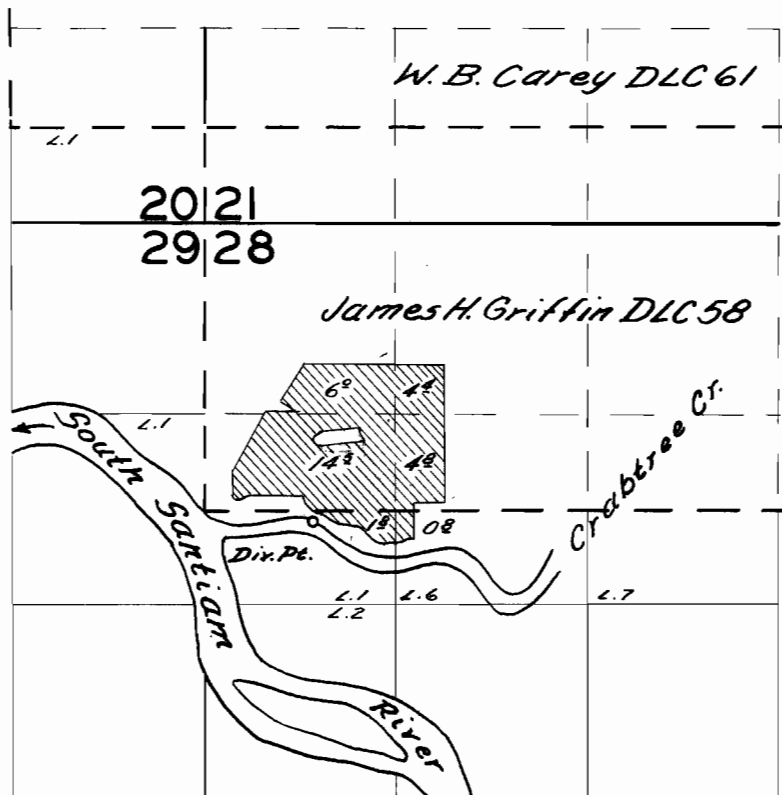

FINAL PROOF SURVEY

UNDER

Application No. 29270 Permit No. 23018
IN NAME OF

J. R. & E. Laura McNowra

Surveyed July 26 1956, by R. H. Whitby

DFN-3D-206