


T. 10 S. R. 1 W. W. M

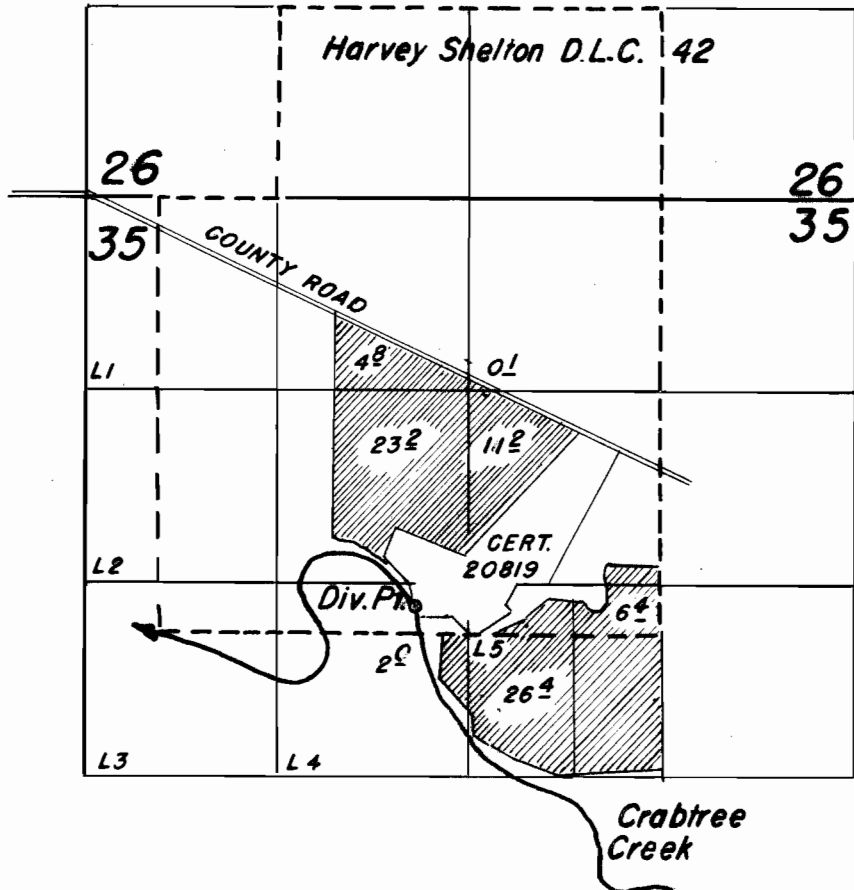

FINAL PROOF SURVEY
UNDER

Application No. 33071 Permit No. 26153
IN NAME OF

George Marcus Krause

Surveyed Feb. 15 1963, by Floyd L. Siegmund