


T.10S.R.1E.W.M.

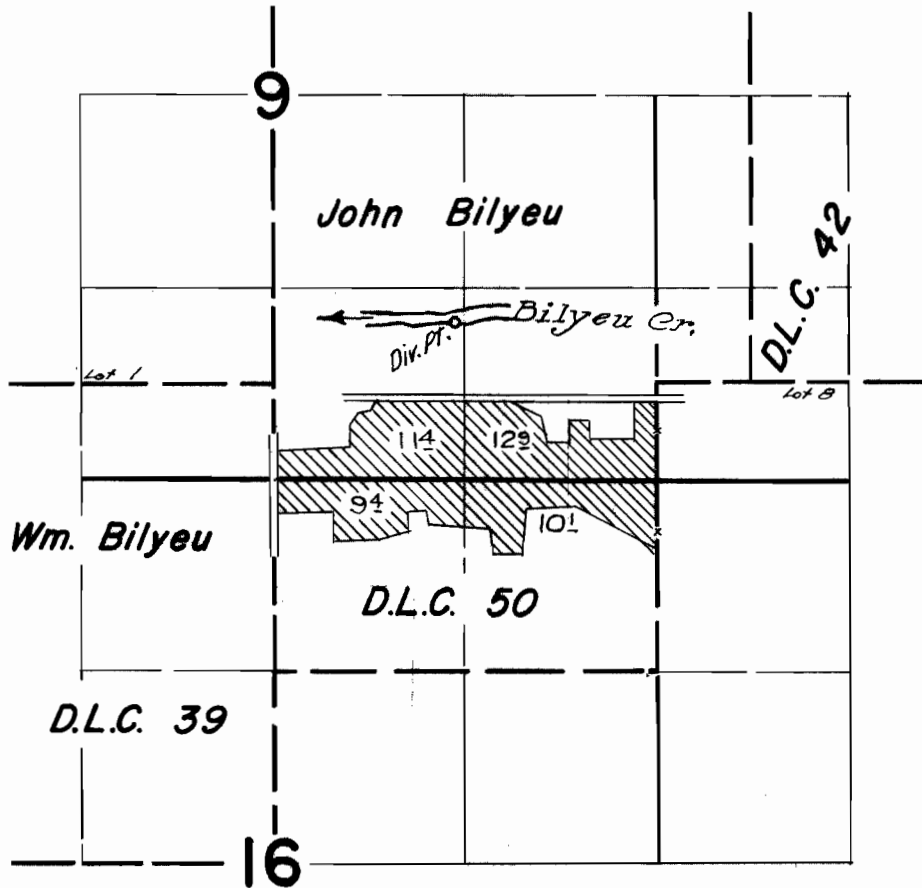

FINAL PROOF SURVEY UNDER

Application No. 33014 Permit No. 26103
IN NAME OF

MADELINE LACKNER

Surveyed July 2, 1963, by C. Baker