


T. 11 S. R. 2 W. W. M.

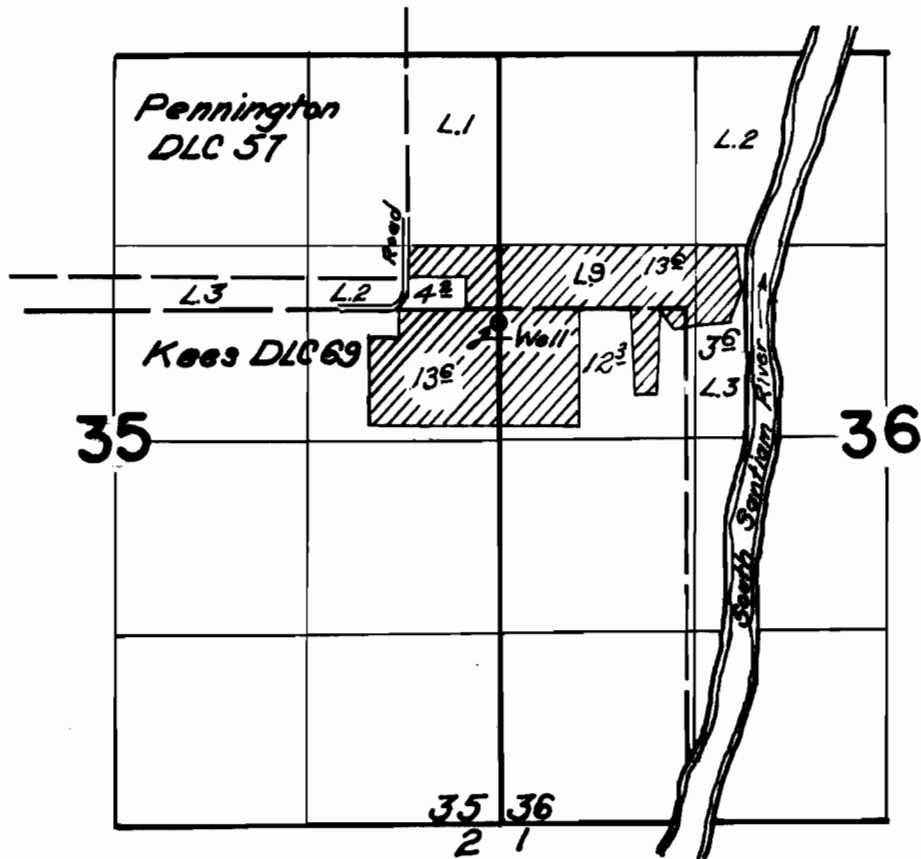

**FINAL PROOF SURVEY**  
UNDER

Application No. *G-1770* Permit No. *G-1622*  
IN NAME OF

*Donovan Farms*

Surveyed *27 Mar.* 19*62*, by *Carl R. Baker*