


T.6S. R.2W. W.M.

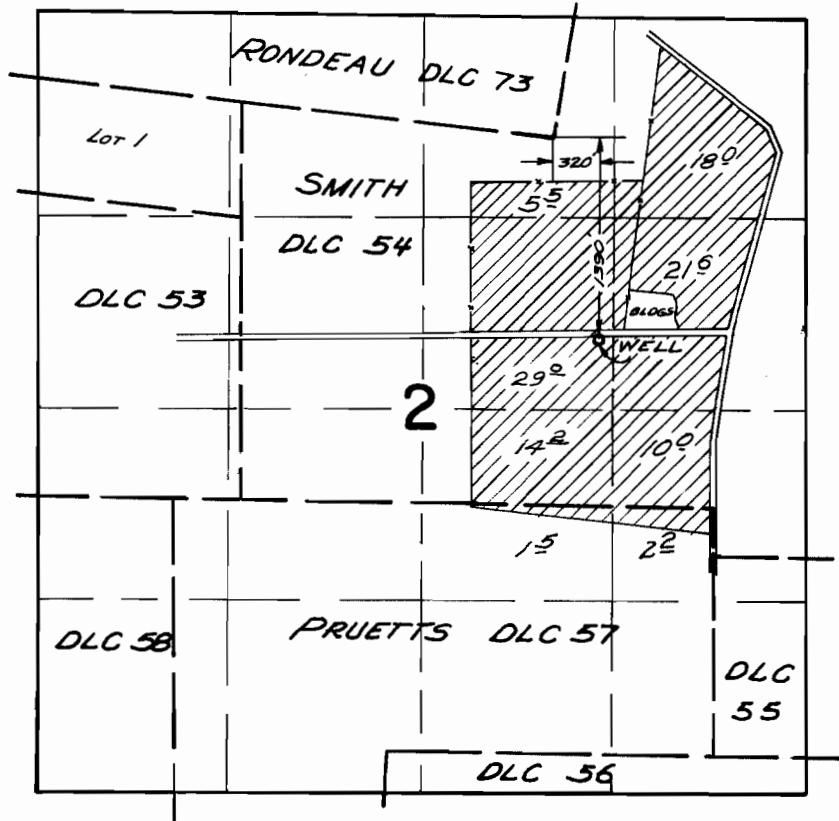

FINAL PROOF SURVEY UNDER

Application No. G:3493. Permit No. G:3291.
IN NAME OF

HESEL BIERMA

Surveyed April 9, 1968, by V. Garner