9009

T. 2 N. R. 15 E. W. M.

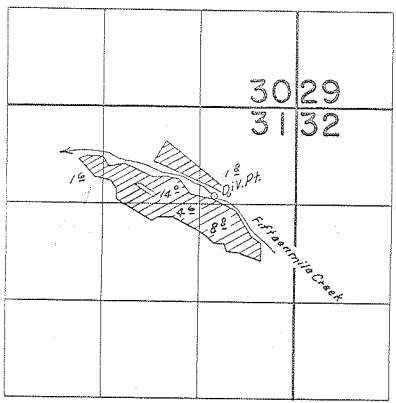

FINAL PROOF SURVEY
UNDER

Transfer No. Q-1 and Q-2

Application No. ..... Permit No. .....

IN NAME OF

CLARENCE E. QUIRK

Surveyed Oct. 19, 1964, by C. J. Gardner

Vol. 14, P. 313
Vol. 12, P. 354

1964-P