

Form AI-187
March 1961


UNITED STATES
DEPARTMENT OF THE INTERIOR
BUREAU OF LAND MANAGEMENT

SECTION
32

Oregon State Water Filings

TOWNSHIP 12 S., RANGE 42 E., W. M. STATE ENGINEER
JAMES O'NEILL

North

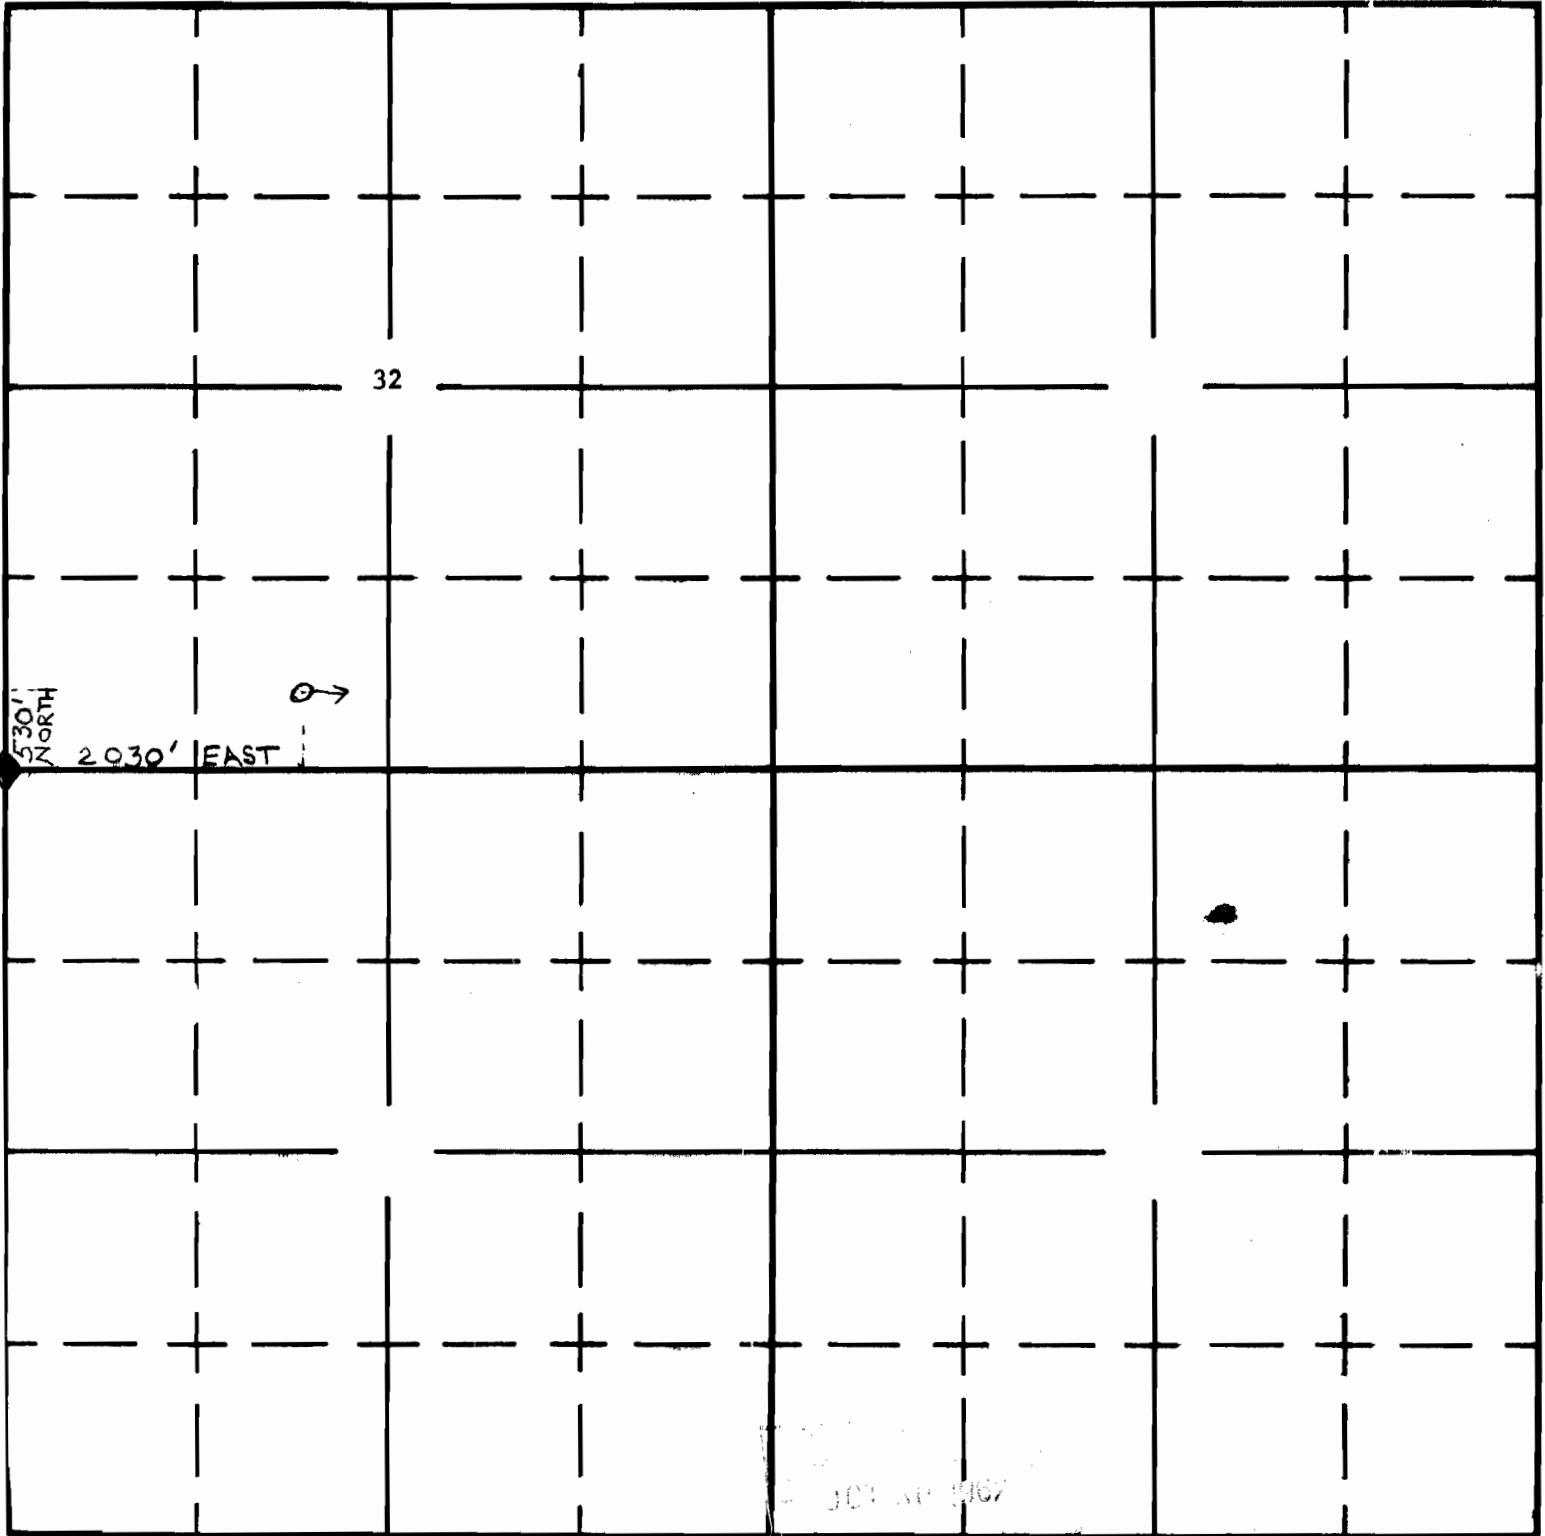

South

APPLICATION No. 38206
PERMIT No. 29761