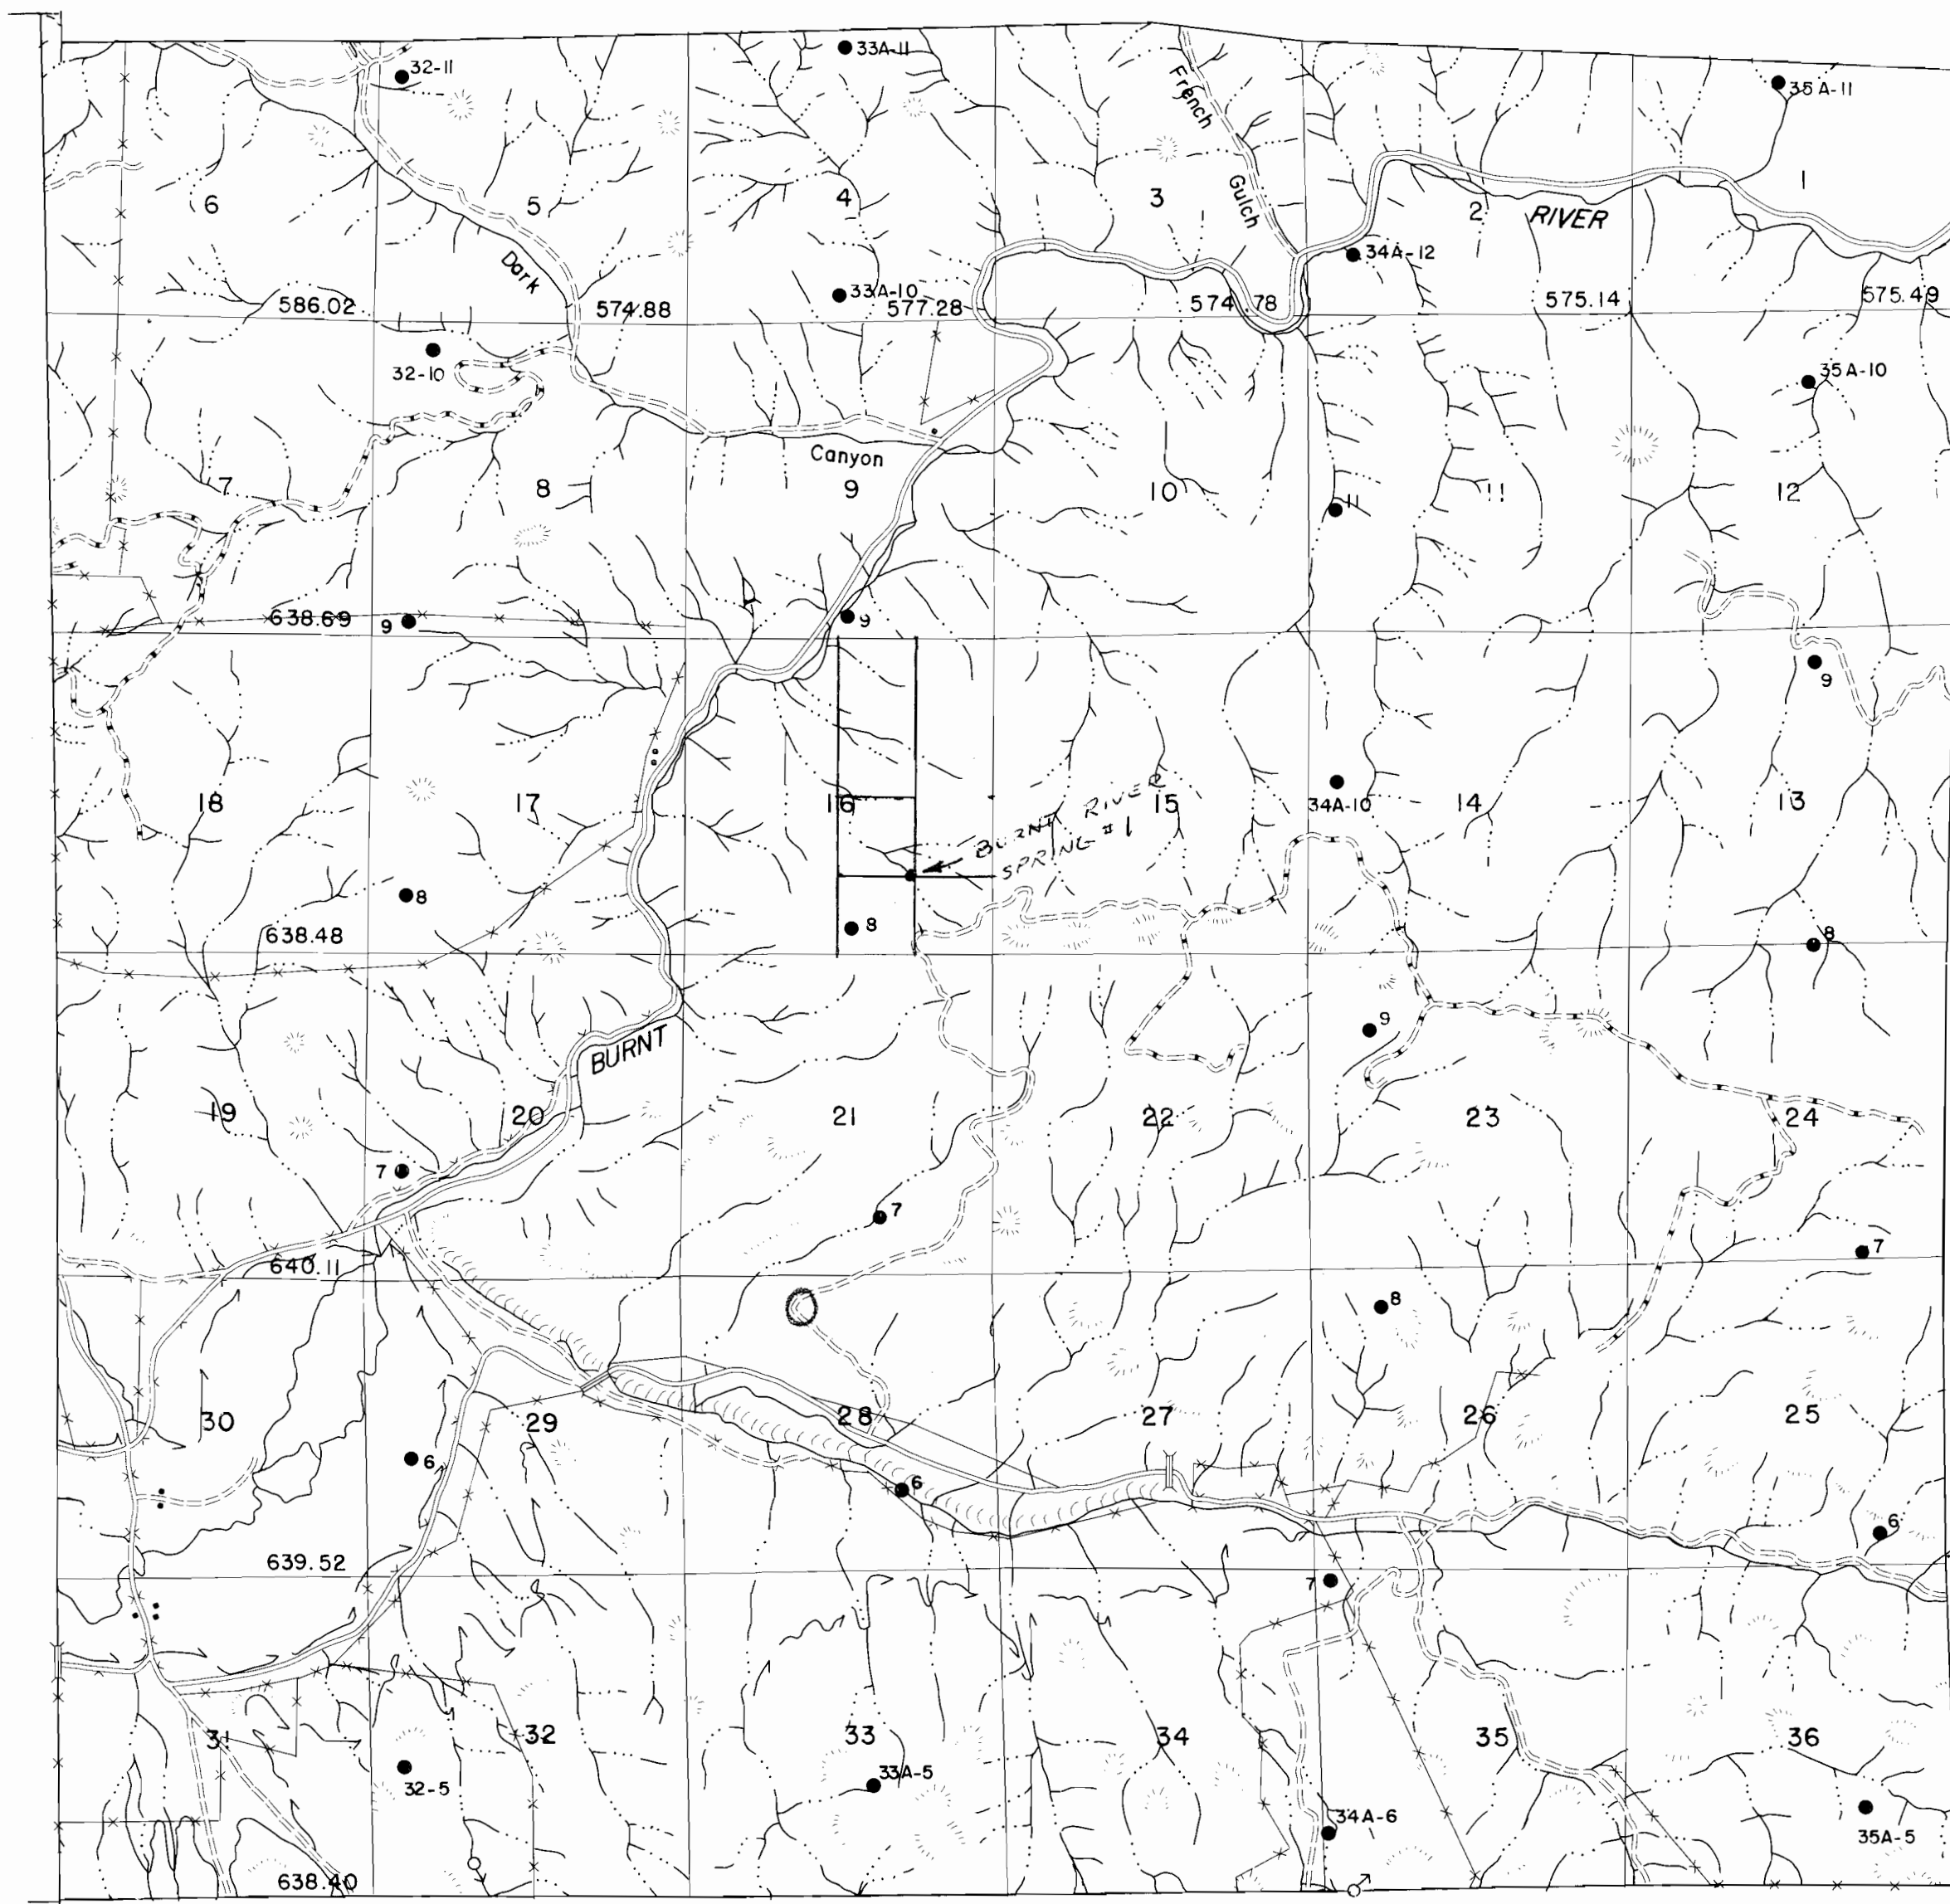


T.12S.,R.41E.

BUREAU OF LAND MANAGEMENT

 UNIT _____
 ALLOTMENT _____

OREGON

 DISTRICT _____
 DATE OF SURVEY _____


APPL. 1
 8-20-75
 RGM.

Photo Project Symbol URM-0 1960
 ◆ Found Corner } Identified in the Field
 ◆ Obliterated Corner

All Sections 640 Acres Except As Noted

Scale 2"=1 Mile