


UNITED STATES
DEPARTMENT OF THE INTERIOR
BUREAU OF LAND MANAGEMENT

SECTION

5

Oregon State Water Filings

TOWNSHIP 14S, RANGE 45E, W. M.

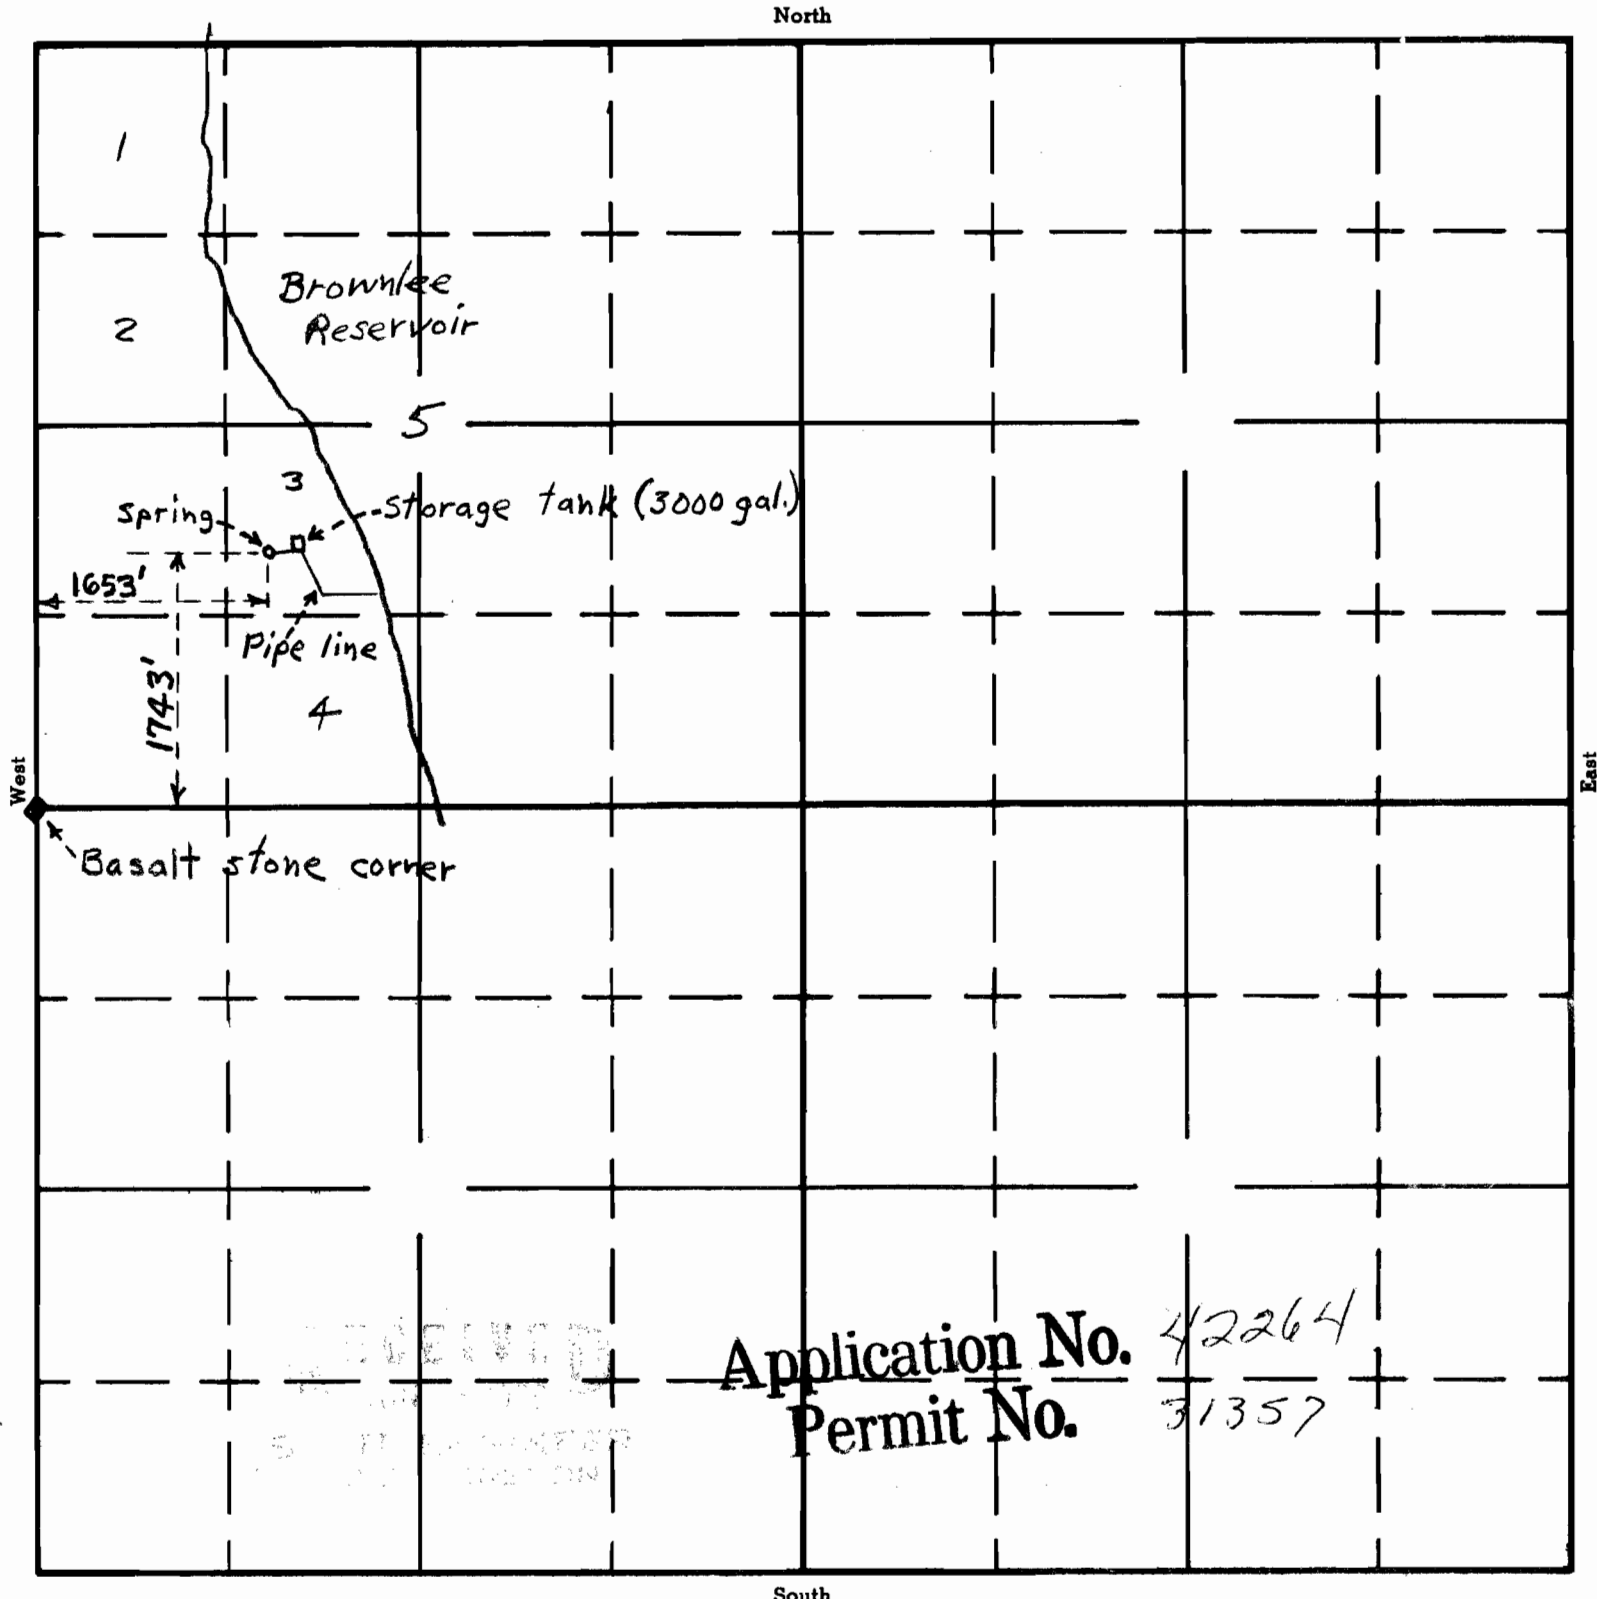

Application No.
Permit No.

42264
31357

APPLICATION No.
PERMIT No.