


T.11S., R.5W., W.M.

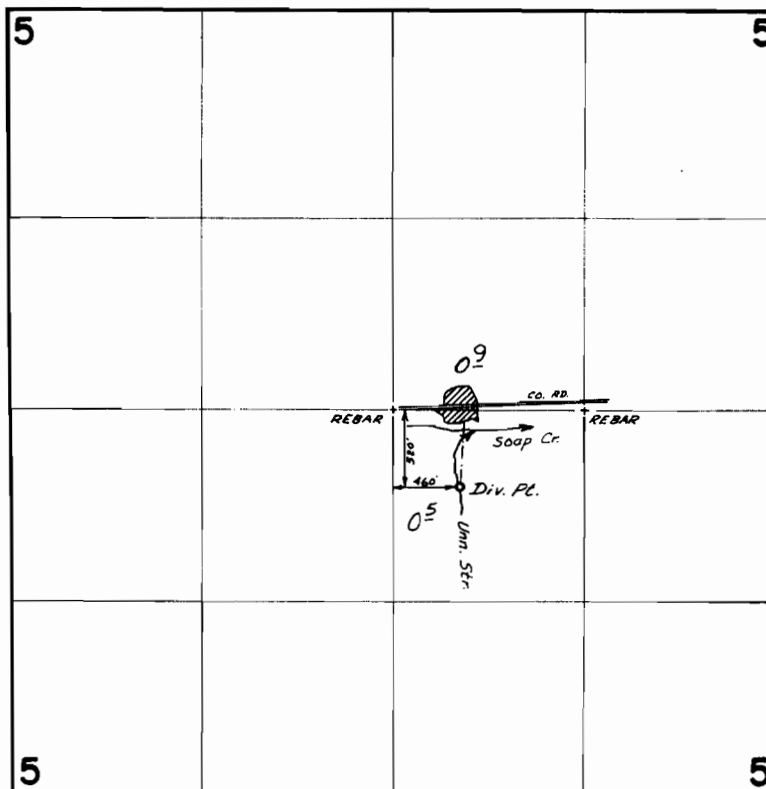

FINAL PROOF SURVEY
UNDER

Application No. 47382 Permit No. 35487
IN NAME OF

MRS. J. E. FETHERSTON

Surveyed Aug. 8 1975, by D. Norby