


T.7 S. R.2 E. W.M.

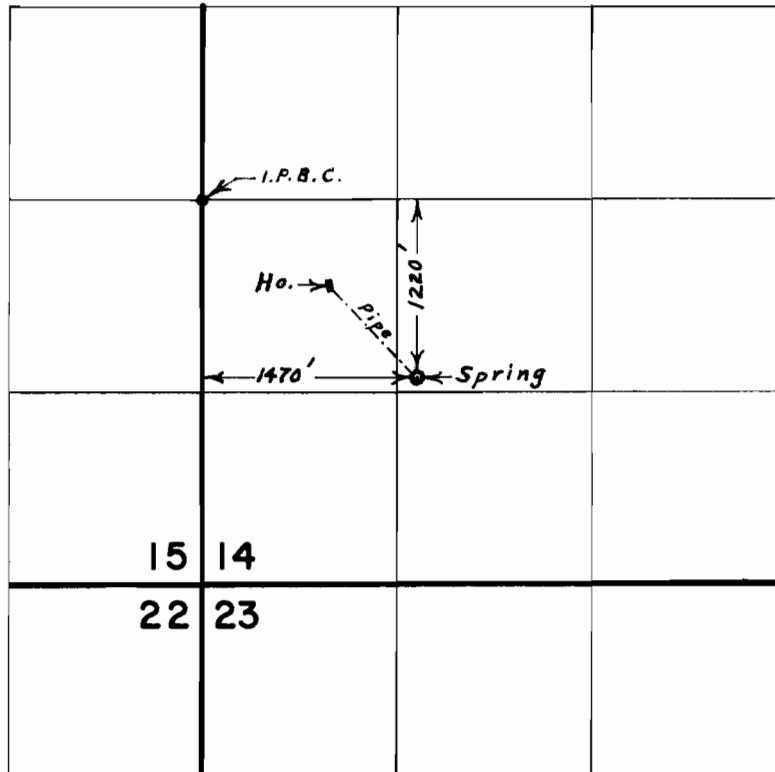

FINAL PROOF SURVEY

UNDER

Application No. 41190 Permit No. 30698

IN NAME OF

DAVID J. AND JOAN M. ZUBER

Surveyed May 27, 1975, by L. E. Gould