


T.24S. R.4W. W.M.

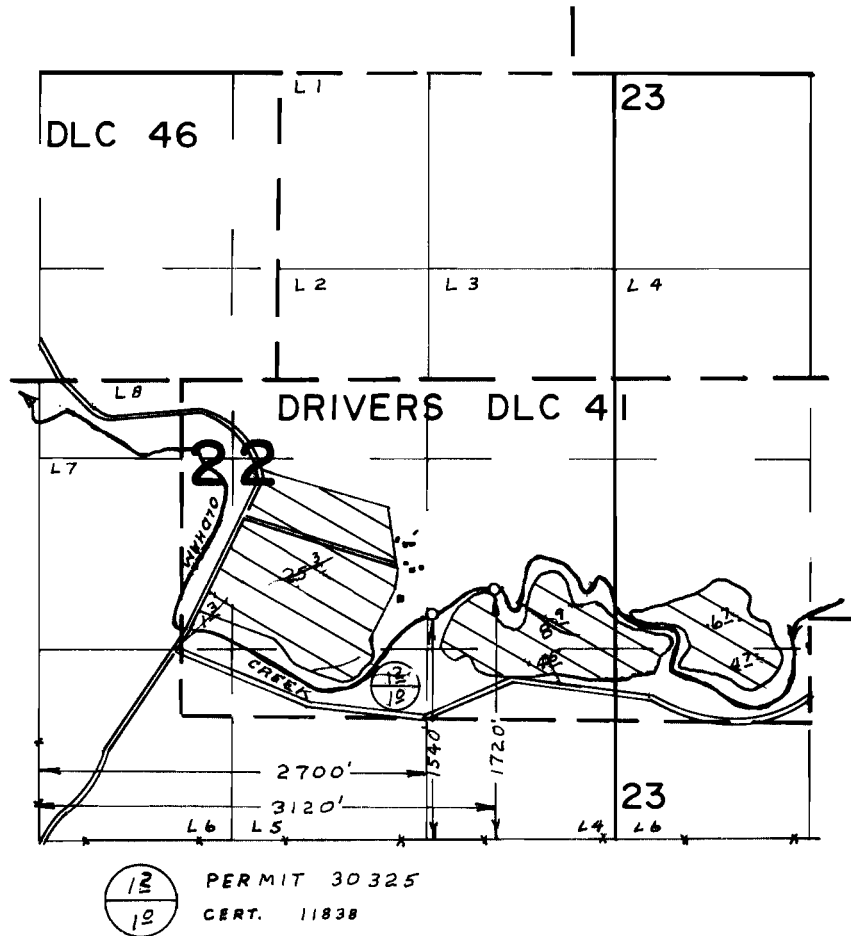

FINAL PROOF SURVEY
UNDER

Application No. 40711... Permit No. 30325...
IN NAME OF

CORNELIUS B. & MERLE C. WALLACE

Surveyed OCT. 3, 1975, by LH NUNN