


T.26S.,R.6W.,W.M.

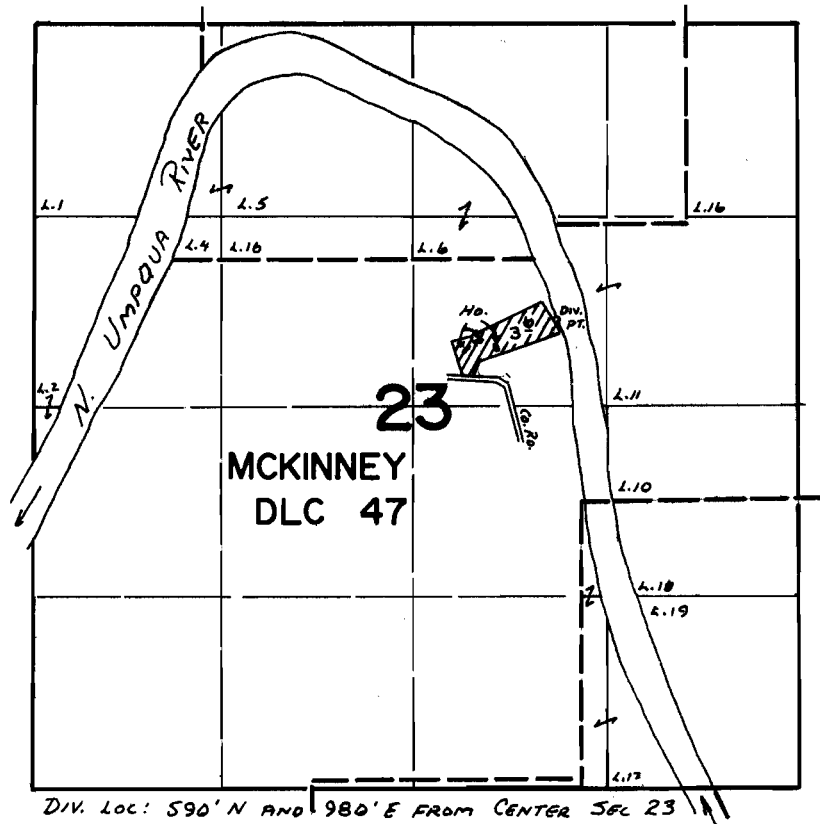

FINAL PROOF SURVEY

UNDER

Application No. 42294 Permit No. 31873

IN NAME OF

L. S. & PHYLLIS M. WOLF

Surveyed JUNE 18 19 74, by L. Toll
SEPT 30, 1975 L. H. NUNN