


T.23S., R.10W., W.M.

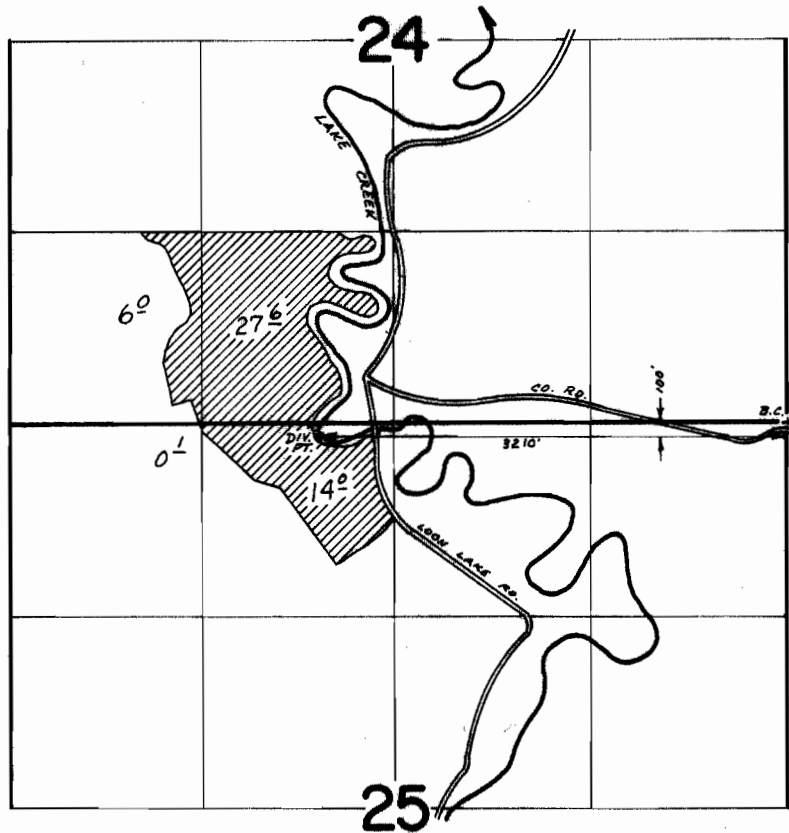

FINAL PROOF SURVEY
UNDER

Application No. 43714 Permit No. 32676
IN NAME OF

EDGAR LEWIS FREDERICKSEN

Surveyed July 23 1975, by D. Norby