


T.29S. R.4W. W.M.

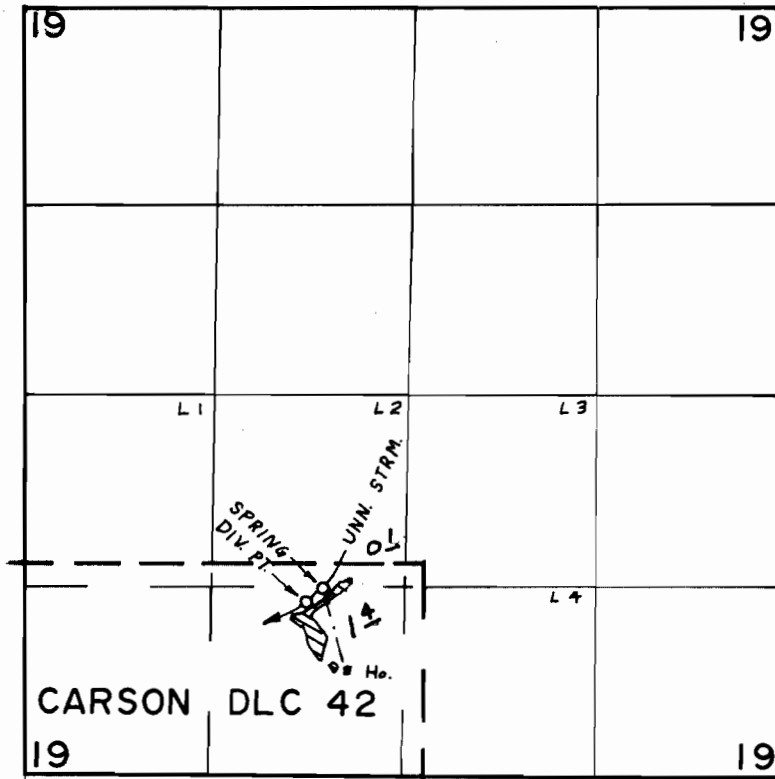

DIV. PT. LOC. 270'S & 800'W, SPRING LOC.
180'S. & 690'W, BOTH FROM NE COR. CARSON
D.L.C. 42

FINAL PROOF SURVEY UNDER

Application No. 44352.... Permit No. 33113.....
IN NAME OF

.....DALE L. FOSTER.....

Surveyed MAR. 27 1975, by L H NUNN.....