


T.26S. R.3W. W.M.

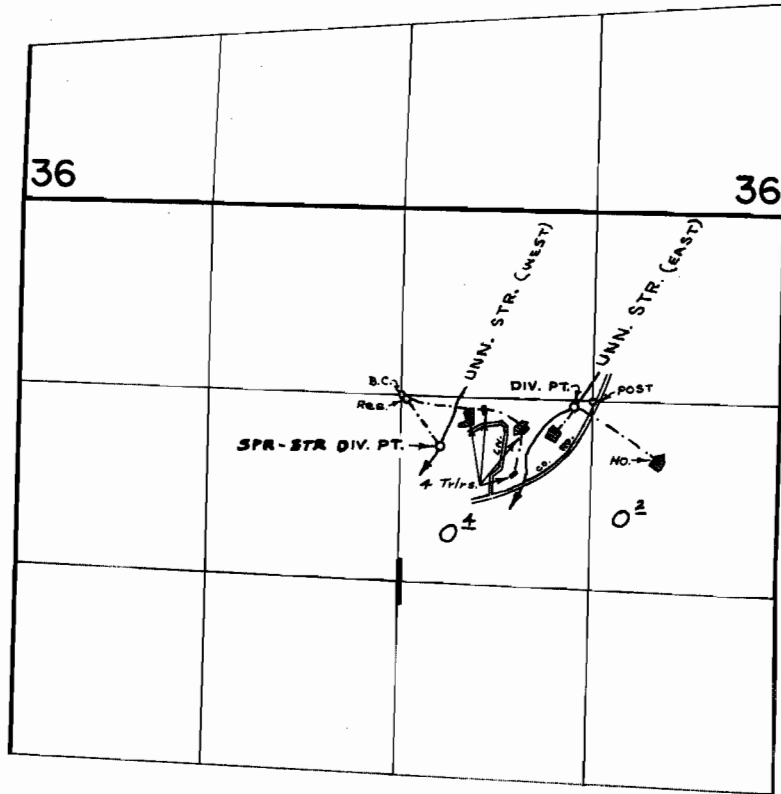

DIV. PTS. LOC: UNN. STR. (EAST) - 40'S AND 1190'E, SPR-STR (WEST) - 340'S AND 270'E. BOTH FROM N.W. COR. SW 1/4 NE 1/4 SECTION 1

FINAL PROOF SURVEY
UNDER

Application No. 44664 Permit No. 33443
IN NAME OF

KENNETH OVERTON

Surveyed SEPT. 18, 1975, by R. MUCKEN