


T.30S.,R.2W.,W.M.

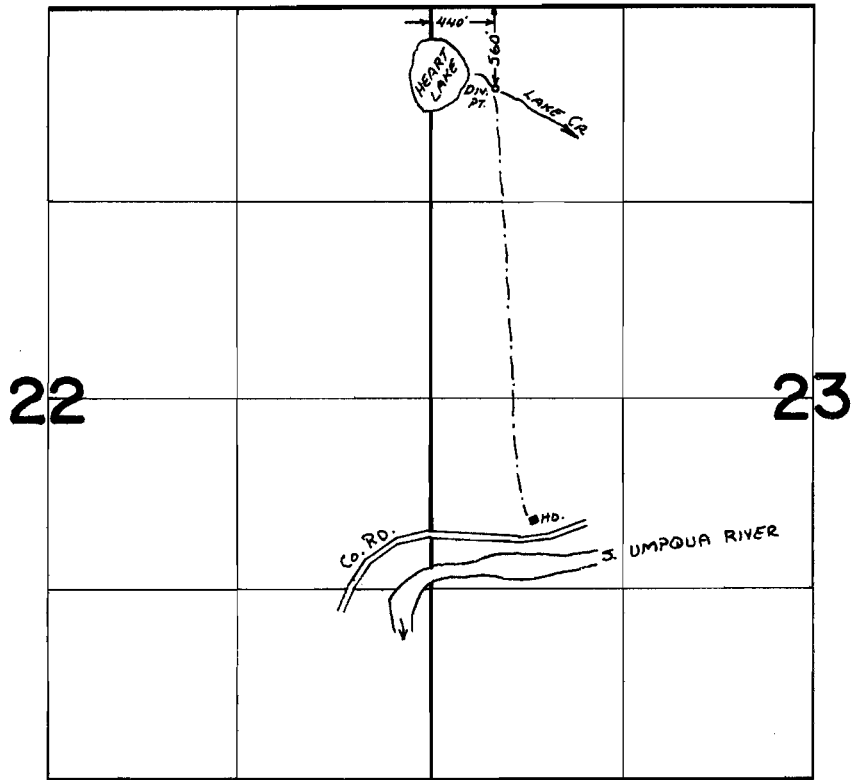

FINAL PROOF SURVEY

UNDER

Application No. 47932 Permit No. 35906

IN NAME OF

DAVID W. RONK

Surveyed May 23 19 75, by L. Toll