


T.26S.,R.6W.,W.M.

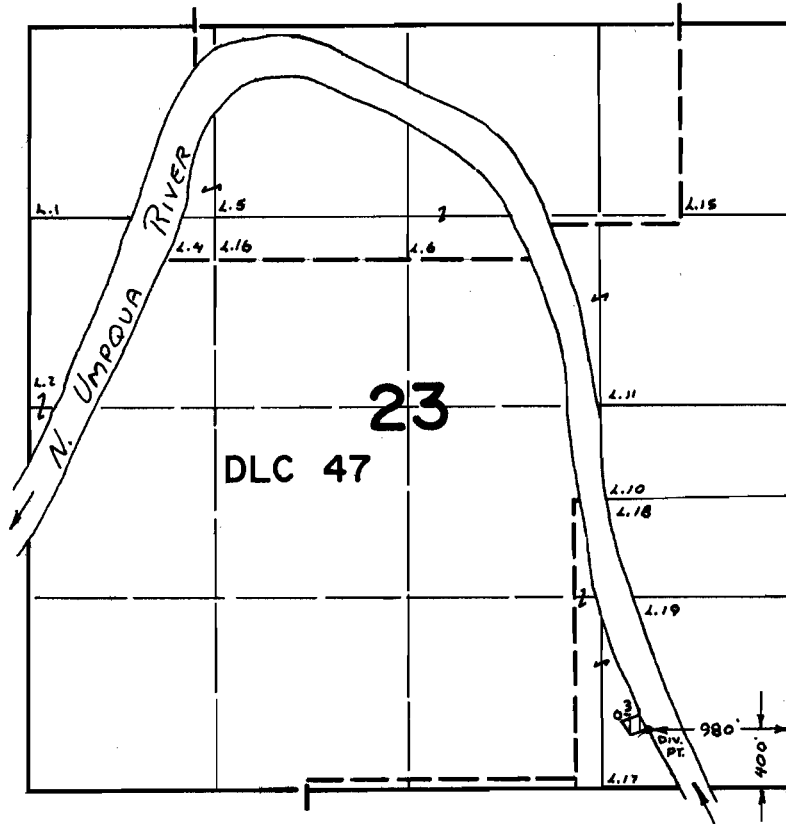

FINAL PROOF SURVEY

UNDER

Application No. **48057** Permit No. **36035**

IN NAME OF

GEORGE M. AVERETT

Surveyed JUNE 18 19 74, by L. Toll
SEPT. 30, 1975 L. H. NUNN