


# T.27S. R.6W. W.M.

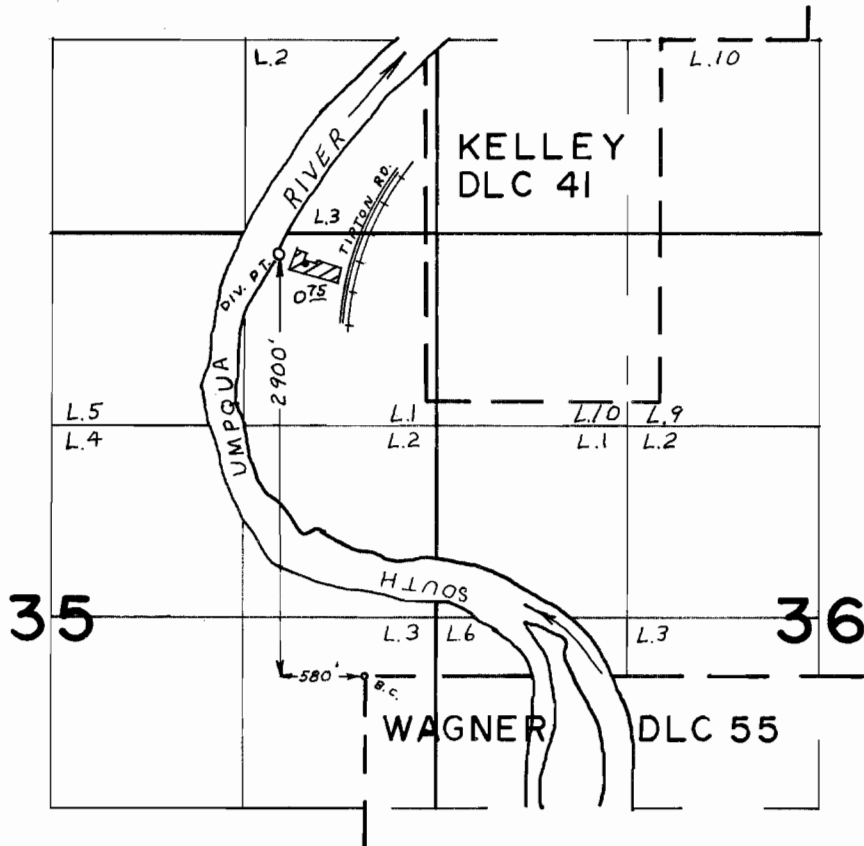

## FINAL PROOF SURVEY UNDER

Application No. 48227... Permit No. 36219  
IN NAME OF

SUN STUDS, INC.

Surveyed MAR. 25 1975, by L.H. NUNN