


T.29S. R.5W. W.M.

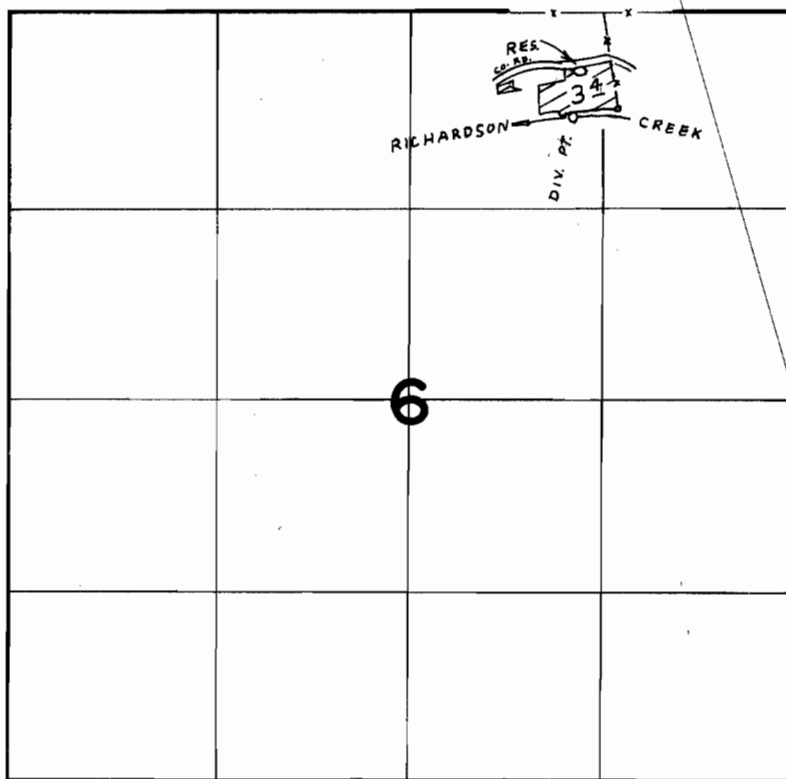

DIV. PT. LOC. 630'S & 150'W; POND LOC. 440'S & 150'W; BOTH FROM NE COR., NW $\frac{1}{4}$ NE $\frac{1}{4}$, SEC. 6

FINAL PROOF SURVEY
UNDER

48486

36384

Application No. R-48735 Permit No. R-5893
IN NAME OF

WALLACE T. RICHARDSON

Surveyed MAR. 27. 1975, by L.H. NUNN