


T.28S. R.6W. W.M.

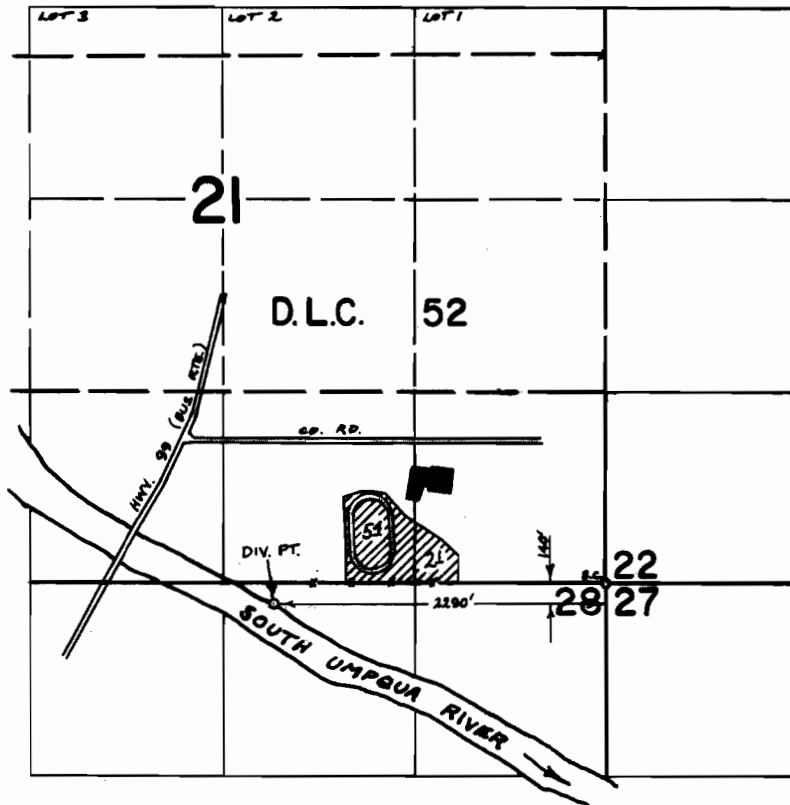

FINAL PROOF SURVEY
UNDER

Application No. 50065 Permit No. 36540
IN NAME OF

WINSTON-DILLARD SCHOOL DISTRICT NO. 116

Surveyed MARCH 28 1975, by L. TOLL