


T.29S. R.8W. W.M.

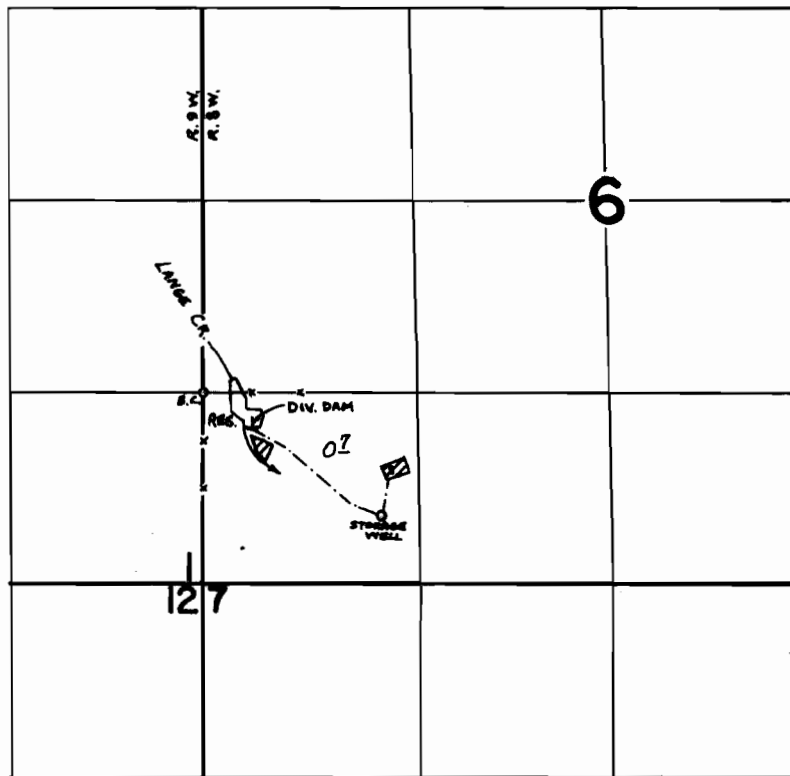

DAM LOCATED: 250' S. & 340' E. FROM NW COR SW 1/4 SW 1/4 SEC 6

FINAL PROOF SURVEY
UNDER

Application No. 48710 Permit No. 36547
IN NAME OF

ROBERT P. WHEELER

Surveyed MARCH 25 1975, by L. TOLL