


T.30S. R.2W. W.M.

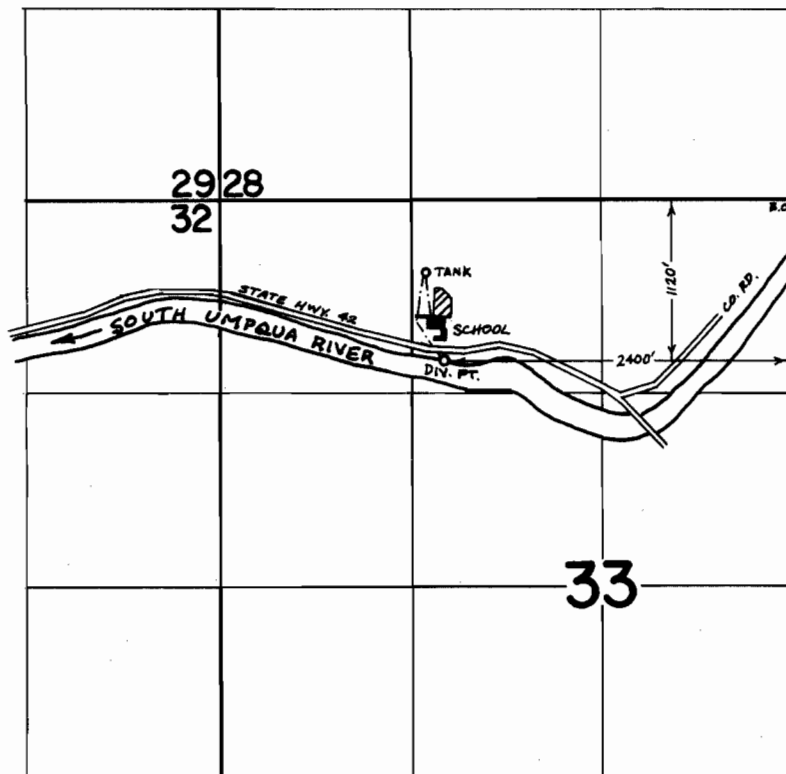

FINAL PROOF SURVEY
UNDER

Application No. 49198 Permit No. 36879
IN NAME OF

ADMINISTRATIVE SCHOOL DISTRICT NO. 15

Surveyed MAY 22 1975, by L. TOLL