


Page I

T. 9 S. R. 27 E. W. M.

SRR VOL 15, P-162

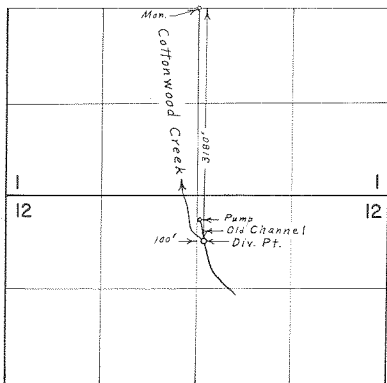

FINAL PROOF SURVEY
UNDER

Application No. _____ Transfer C-160
Permit No. _____ *Permit C-44067*

IN NAME OF

RICHARD COX

Surveyed July 20, 1971, by L. E. Gould.


C-44067

Per C-160

Page #

6

SEE VOL 15 PAGE 162

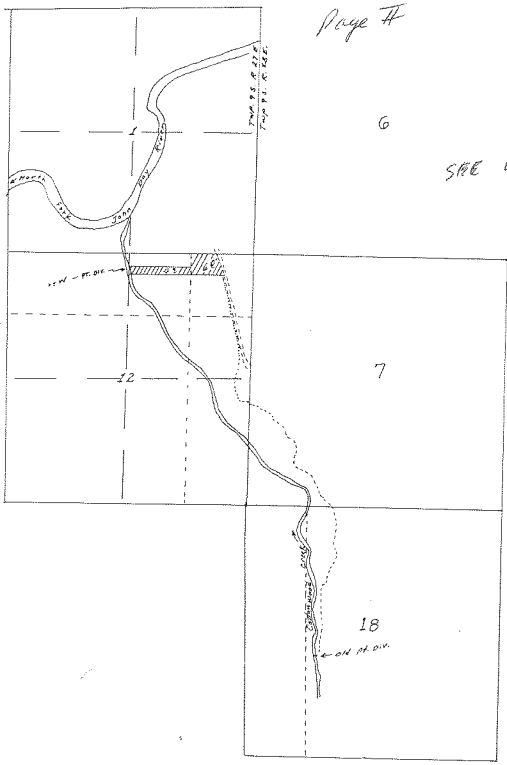

RECEIVED
 MAY 10 1965
 STATE ENGINEER
 SALEM, OREGON

RECEIVED
 MAY 10 1965
 STATE ENGINEER
 SALEM, OREGON

Scale 4 to 1 mile