


T.15S. R.31E. W. M.

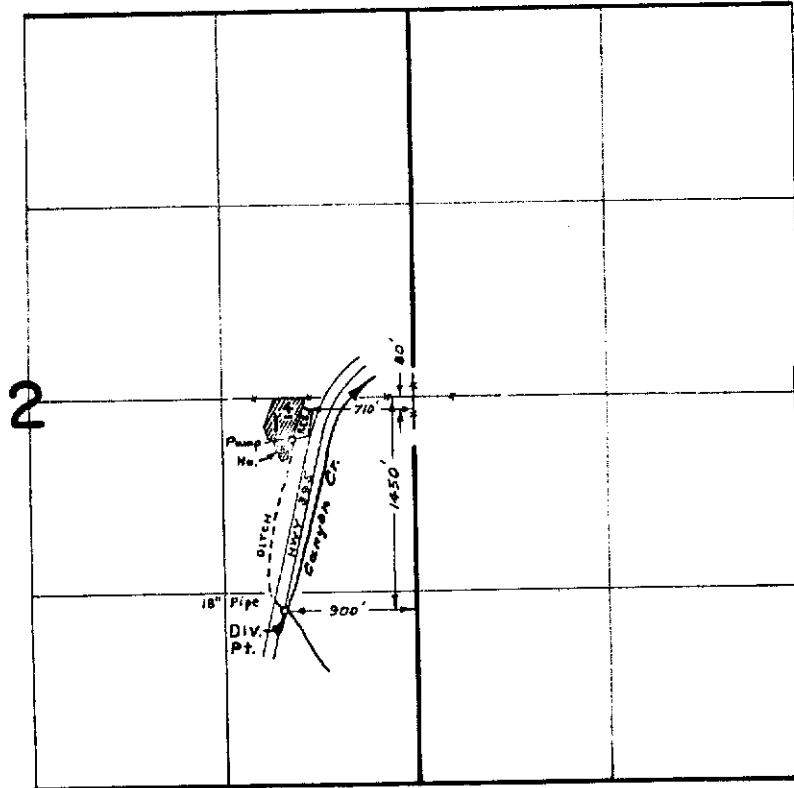

FINAL PROOF SURVEY UNDER

Transfer No. G-81
46086

34128

Application No. R-45686 Permit No. R-5419

IN NAME OF

J. H. GUERNSEY

Surveyed JUNE 23, 1975, by R. MUCKEN