




P. 28475
TRAN. E-40
44070

T.17&18S., R.28E., W.M.

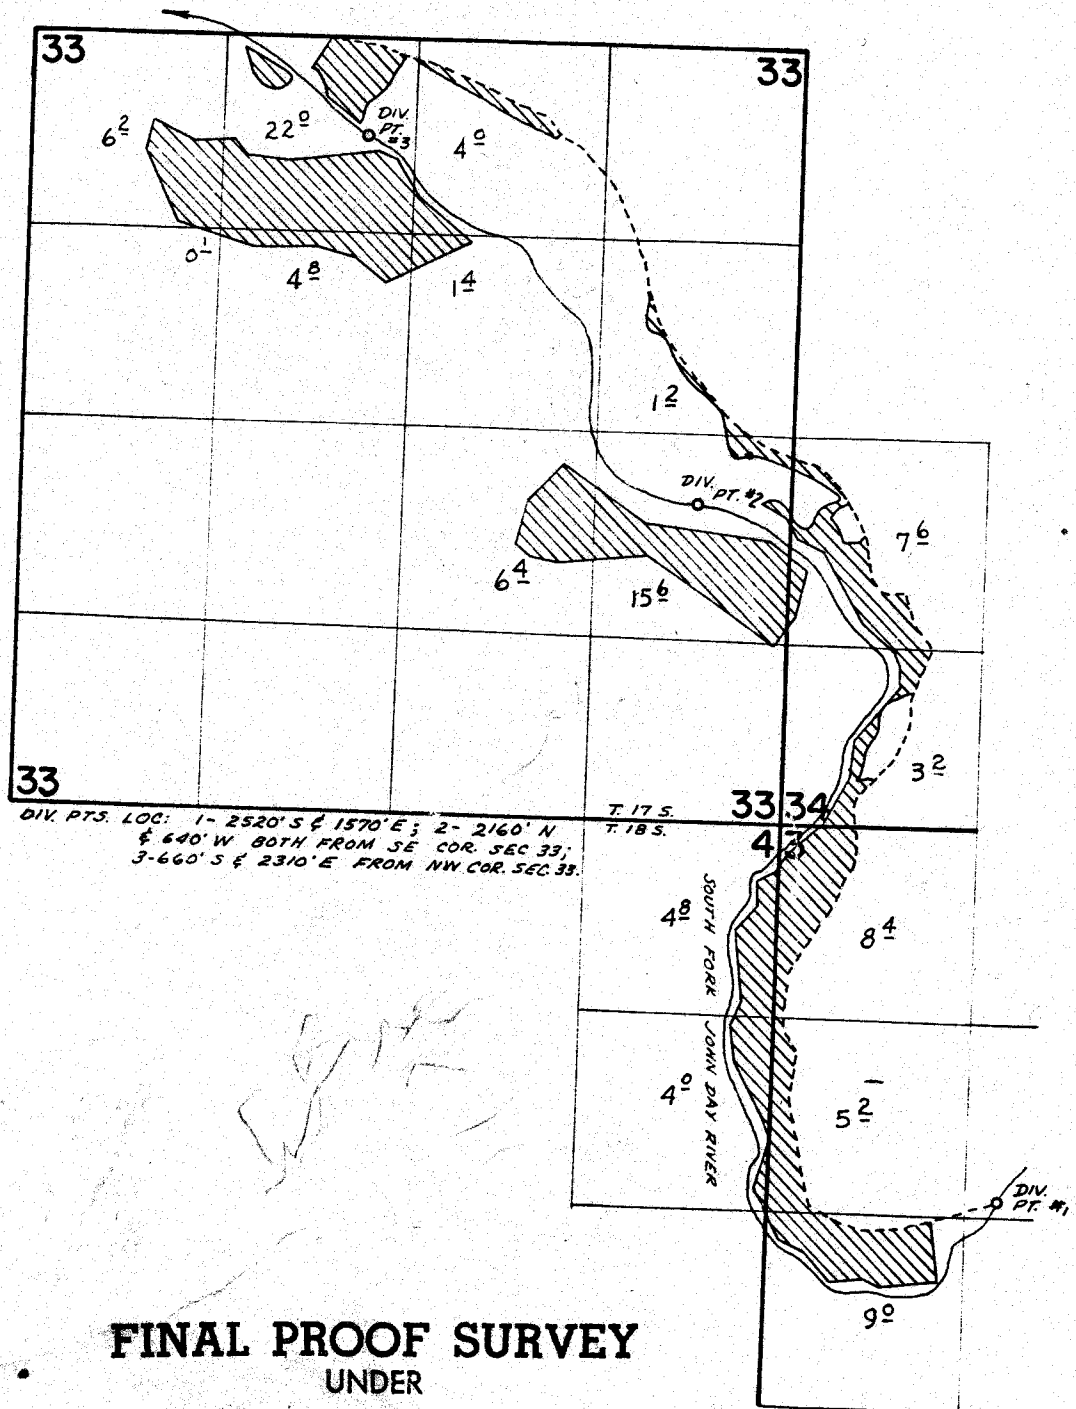



Transfer No. E-40
Application No. 38218..... Permit No. 28475.....
IN NAME OF
MALCOLM & LIZA JANE MacNAUGHTON
Surveyed Oct. 10, 1974, by D. Norby.....

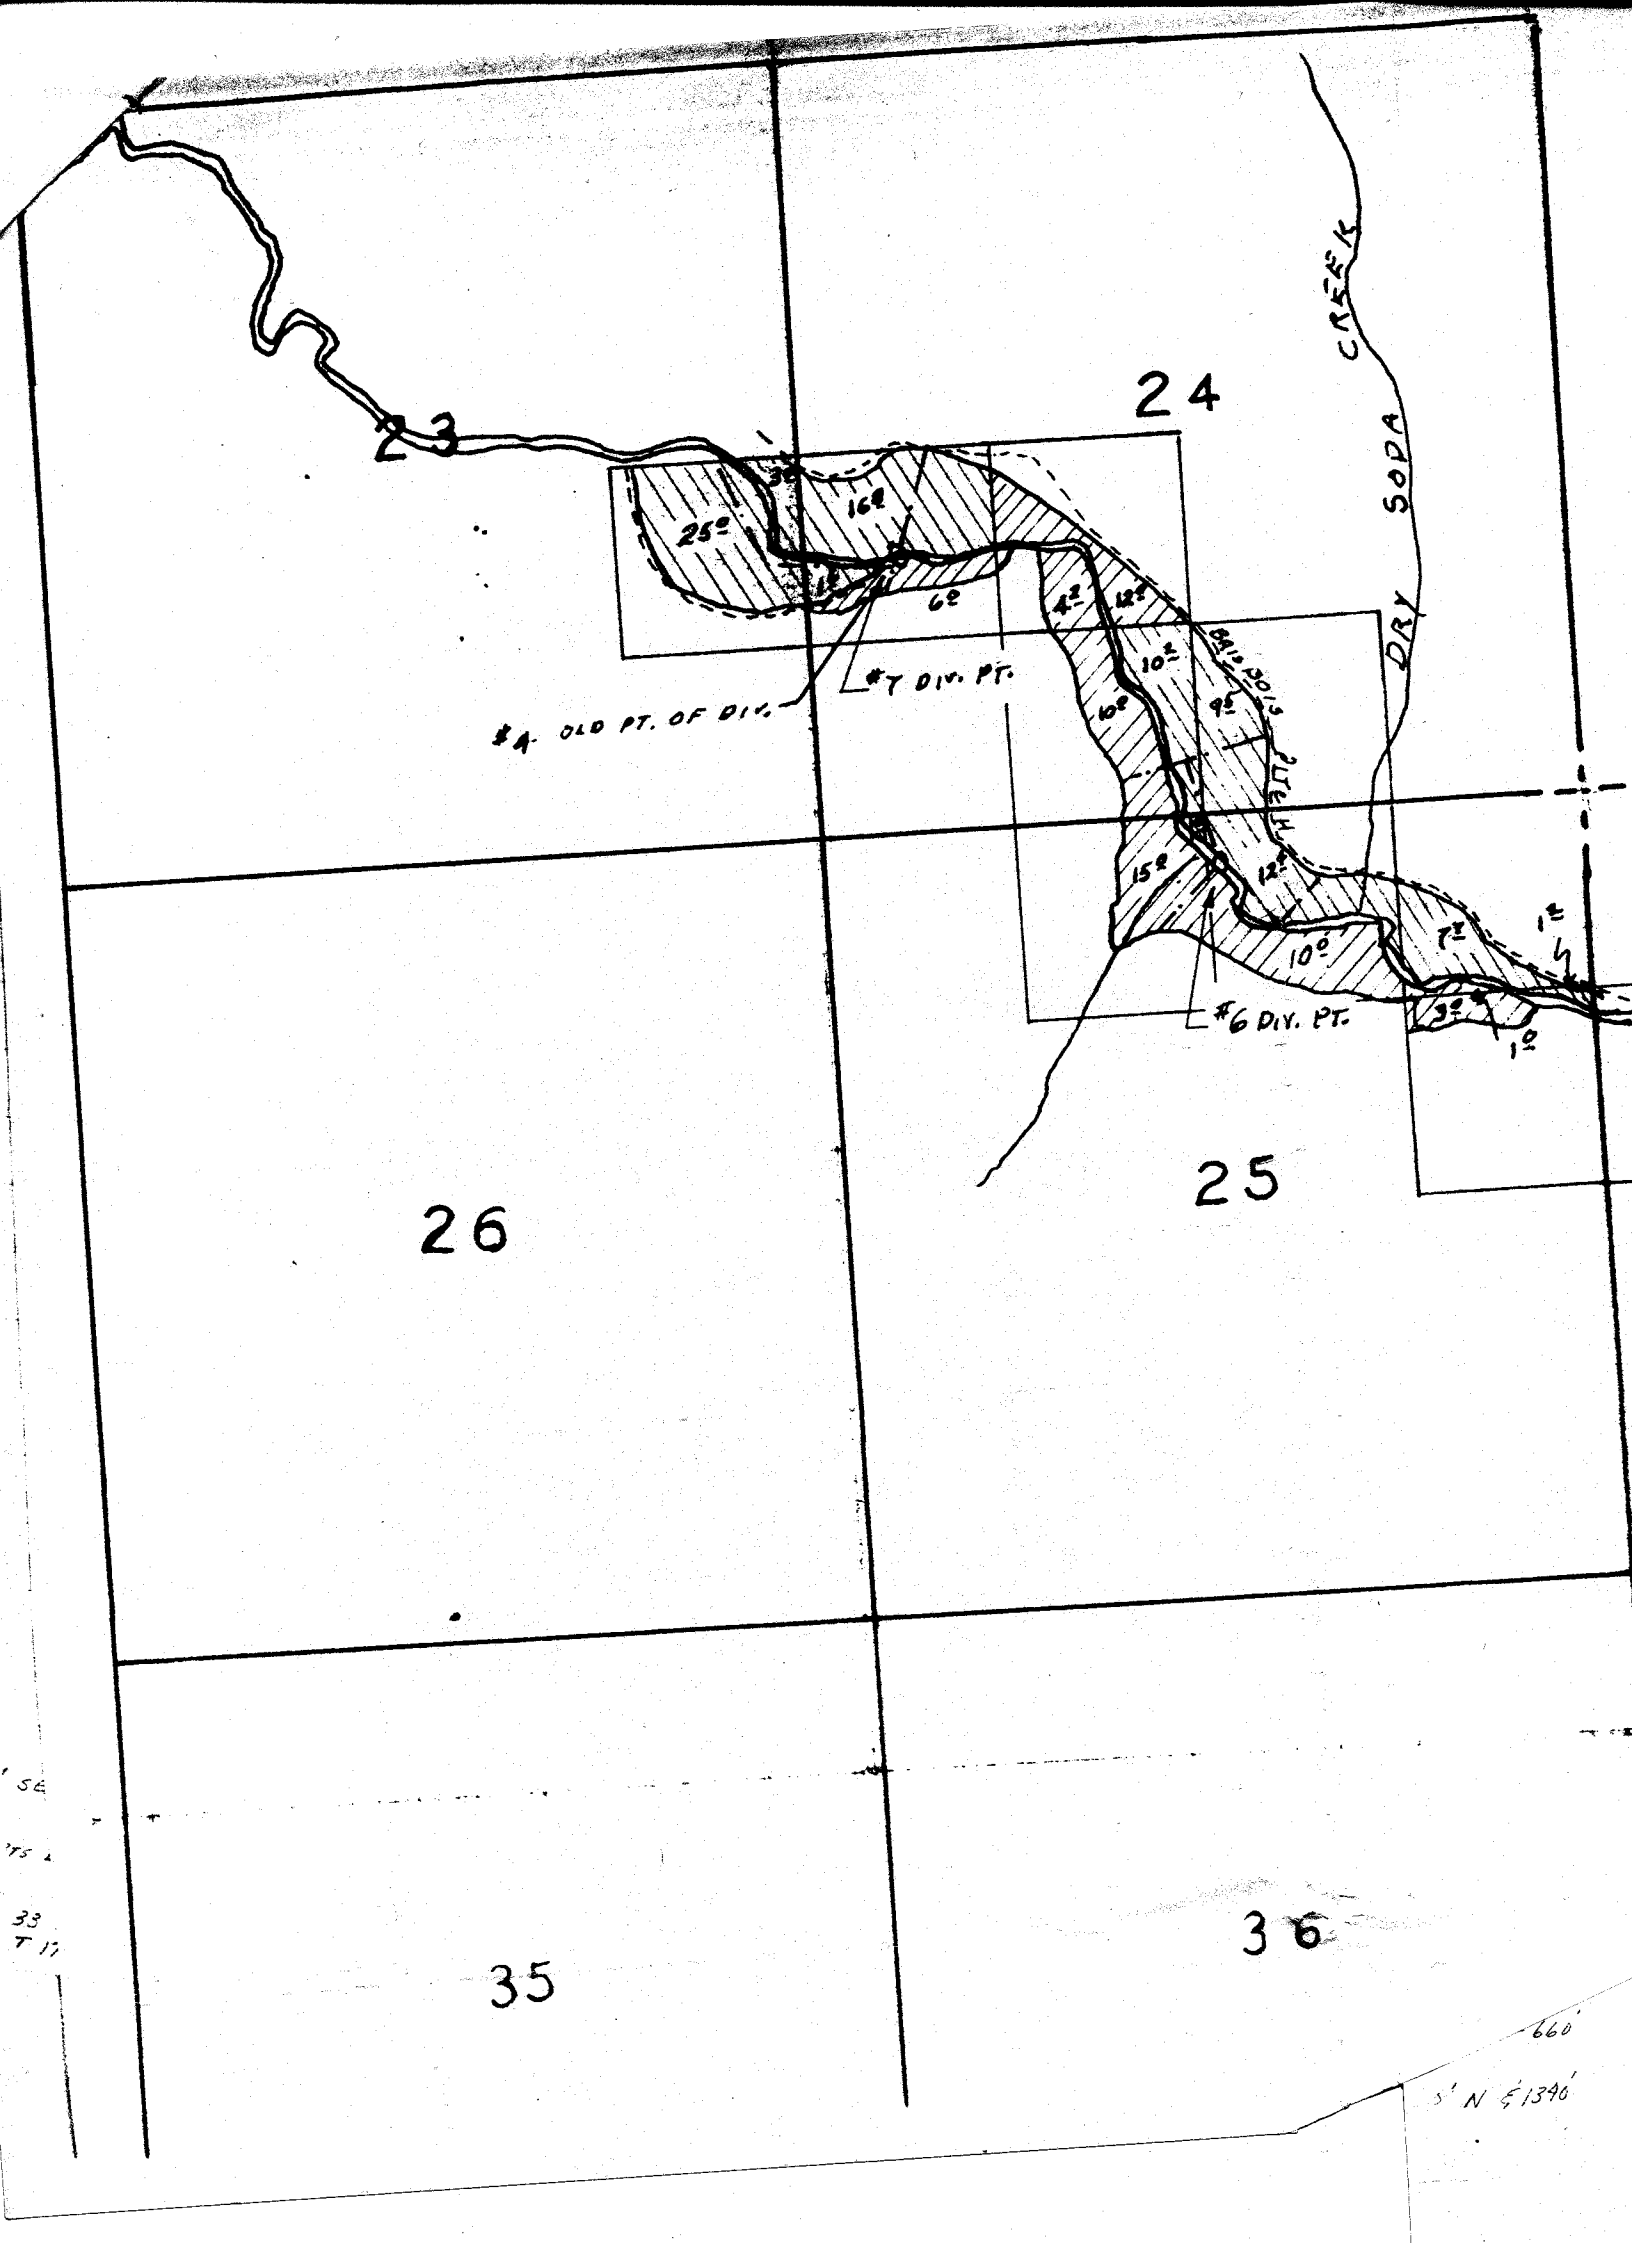

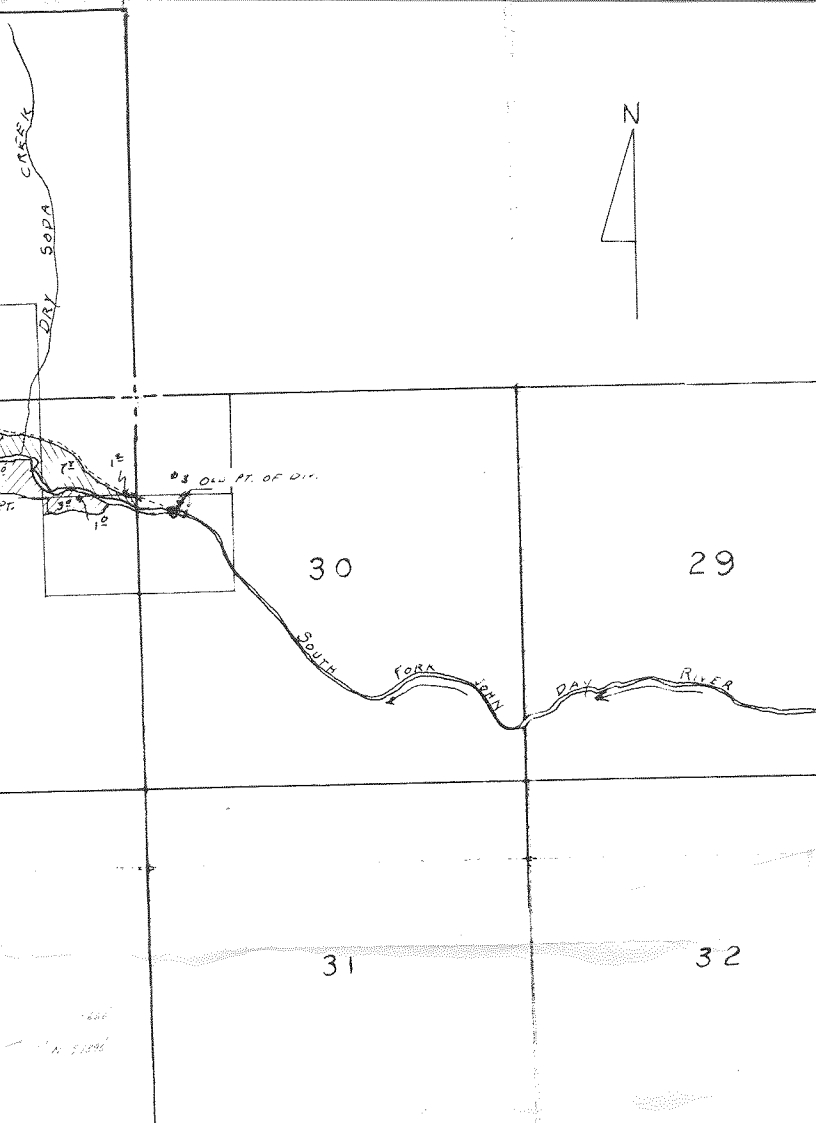

MAP TAKEN FROM SCS SURVEY,
ADJUDICATION MAPS AND
AERIAL PHOTOS

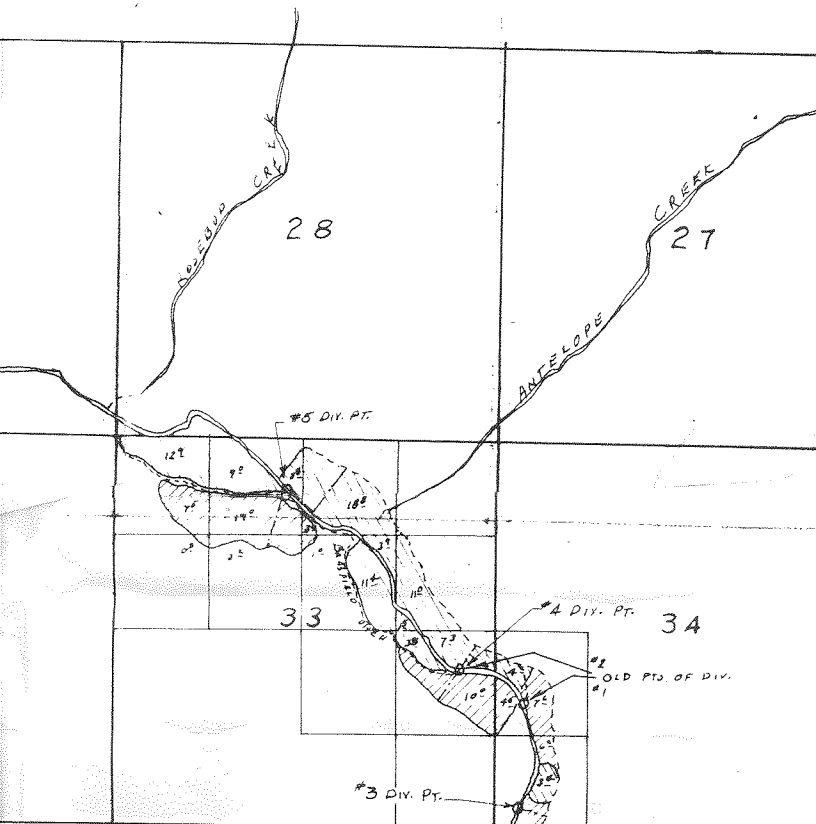

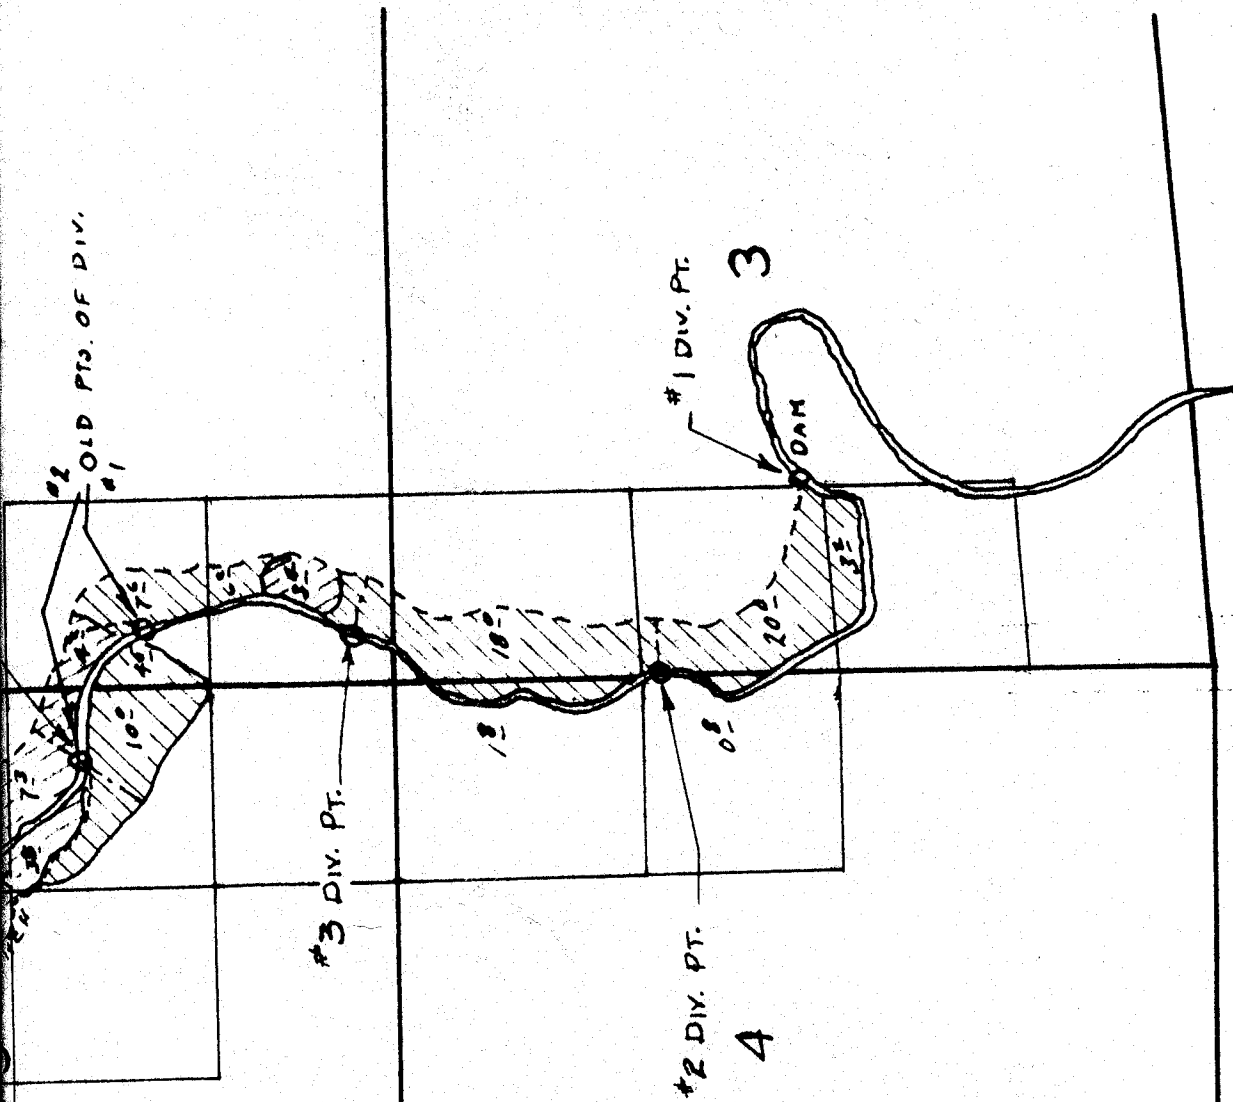

30218
 Application No. 28475
 Permit No. 2

660
S N 51396

3.27E.

TP. 17S., R. 28E.
TP. 18S., R. 28E.

31

32

6

5



*2