


T. 23 S. R. 31 E. W. M.

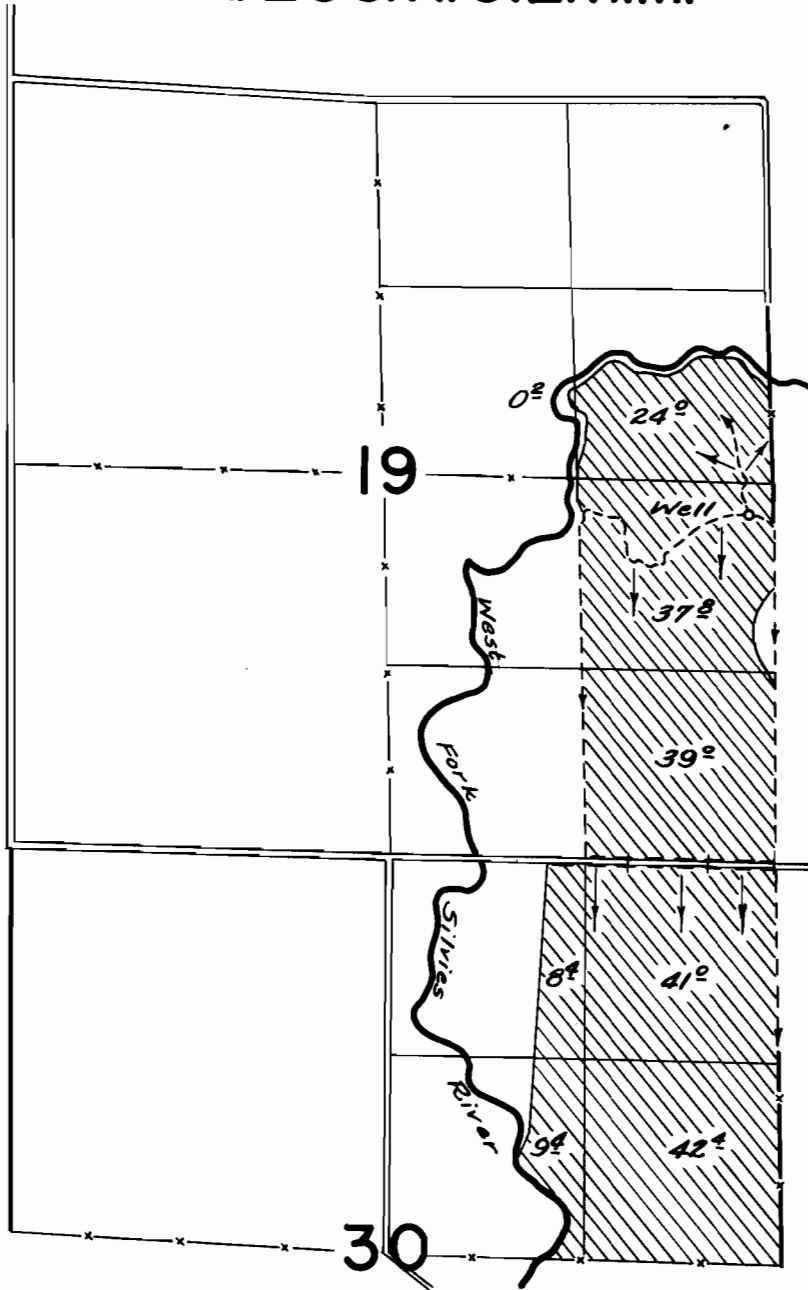

FINAL PROOF SURVEY
UNDER

Application No. *G-117* Permit No. *G-51*
IN NAME OF

Riddle Ranch Inc.

Surveyed *Oct. 22, 1960*, by *C.D. Baetha*