


T. 38S. R.1W. W.M.

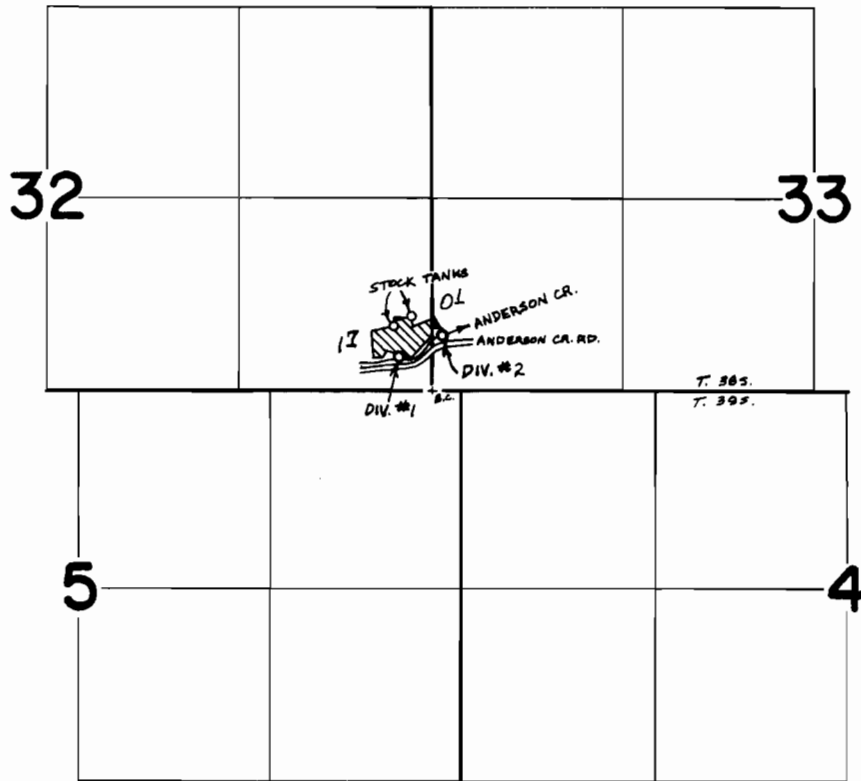

DIV. PTS. LOC: #1-240'N. & 230'W., #2-380'N. & 70'E., BOTH FROM SE COR SEC 32.

- IRRIGATED FROM DIV. #1 (SANDERS)
- IRRIGATED FROM DIV. #2 (FINNEY)

FINAL PROOF SURVEY UNDER

TRANSFER NO. C-173

Application No. Permit No.

IN NAME OF

CECIL SANDERS & HARLEY FINNEY

Surveyed NOV. 1 1975, by L. TOLL