



# T.38 S.R.5 W.W.M.

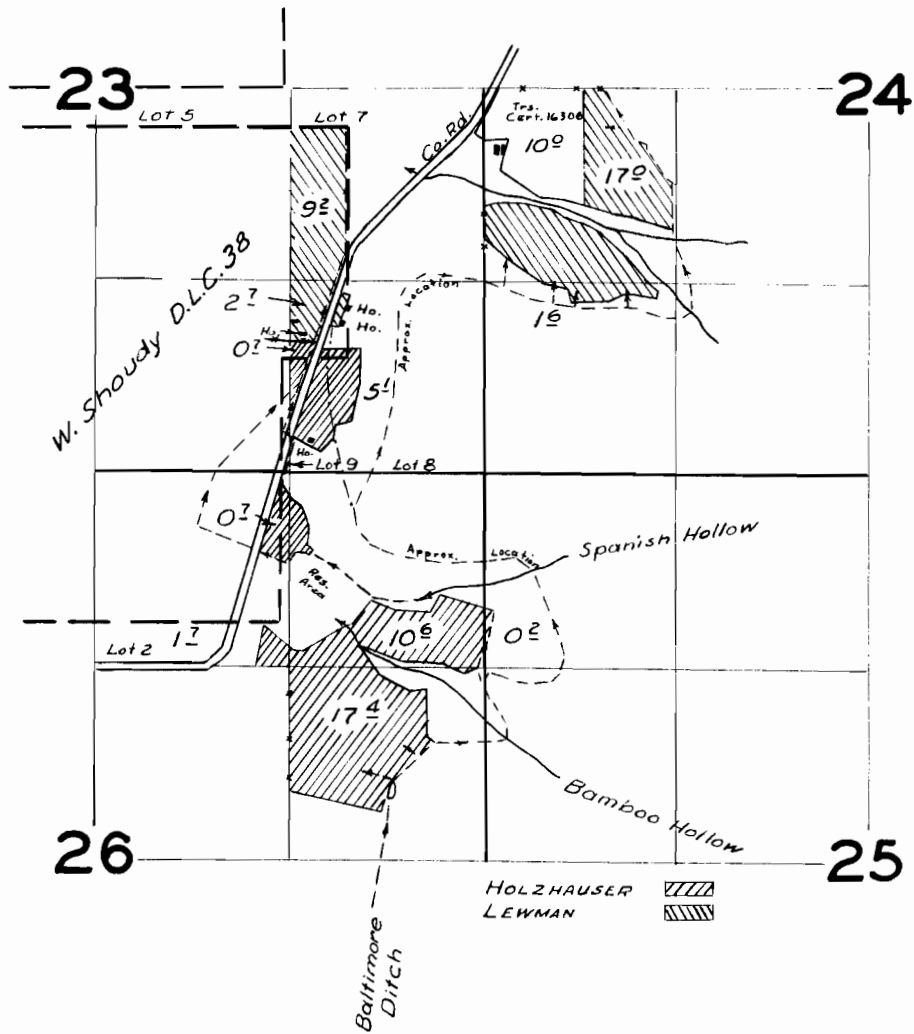

T.39 S.R.5 W.W.M.  
SEC 5

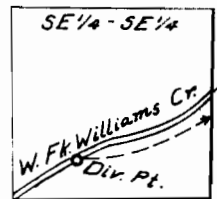

From Adjudication Map

## FINAL PROOF SURVEY UNDER

Application No. 24623 . Permit No. 19388  
IN NAME OF

H.B. HOLZHAUSER, RICHARD F. & GLEN ORVAL LEWMAN

Surveyed 25 July 1959, by *M. B. Bish*