


T.40S.,R.8W.,W.M.

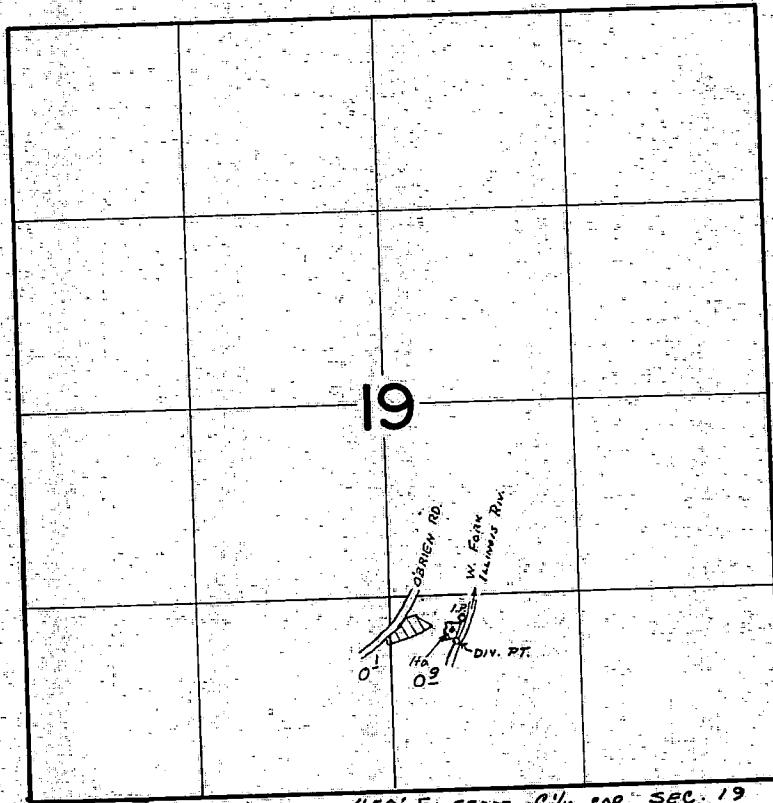

DIV. PT. - 1630' S AND 450' E FROM C<sup>1</sup>/<sub>4</sub> COR. SEC. 19

**FINAL PROOF SURVEY**  
UNDER

Transfer No. 0-57  
2951

Application No. \_\_\_\_\_ Permit No. \_\_\_\_\_  
IN NAME OF

HARRY SONNIER

Surveyed Sept. 10, 1974, by L. Toll