


T.34S. R.7 1/2 E. W.M.

Wood River Mace,

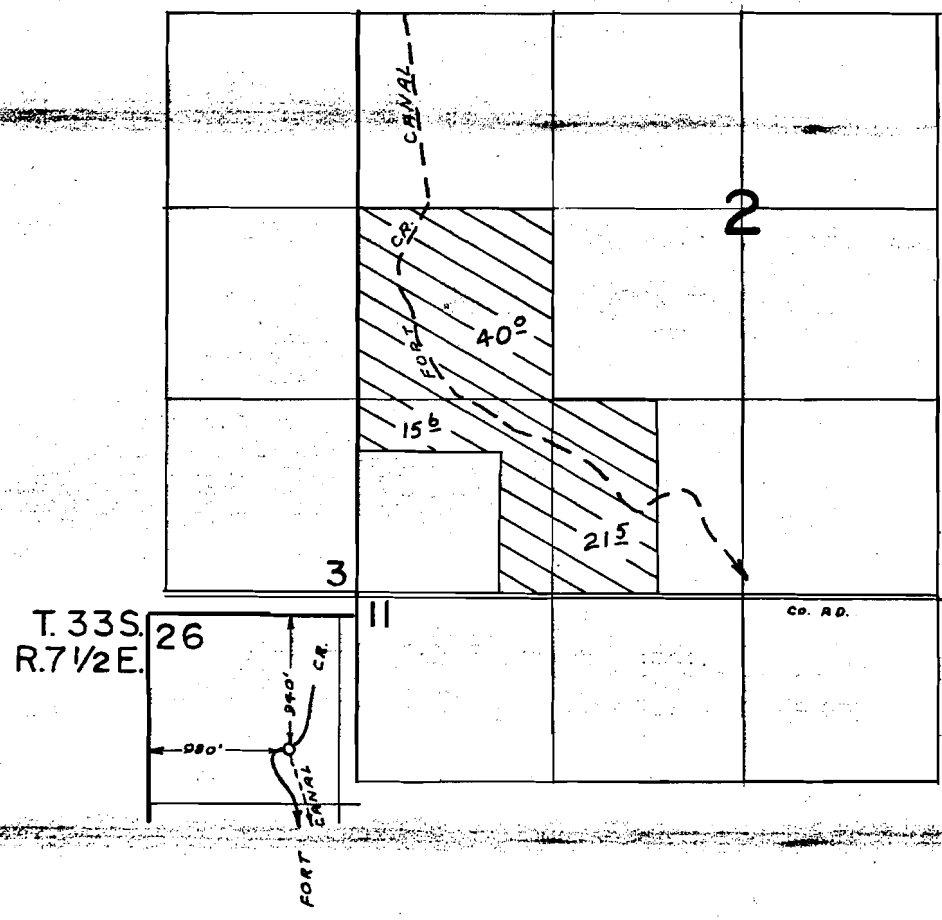

FINAL PROOF SURVEY
UNDER

Application No. 52368... Permit No. 37505
IN NAME OF

ROGER NICHOLSON

Surveyed JUN. 6. 1975, by LH NUNN