


T. 35 S.R. 1 E.W.M.

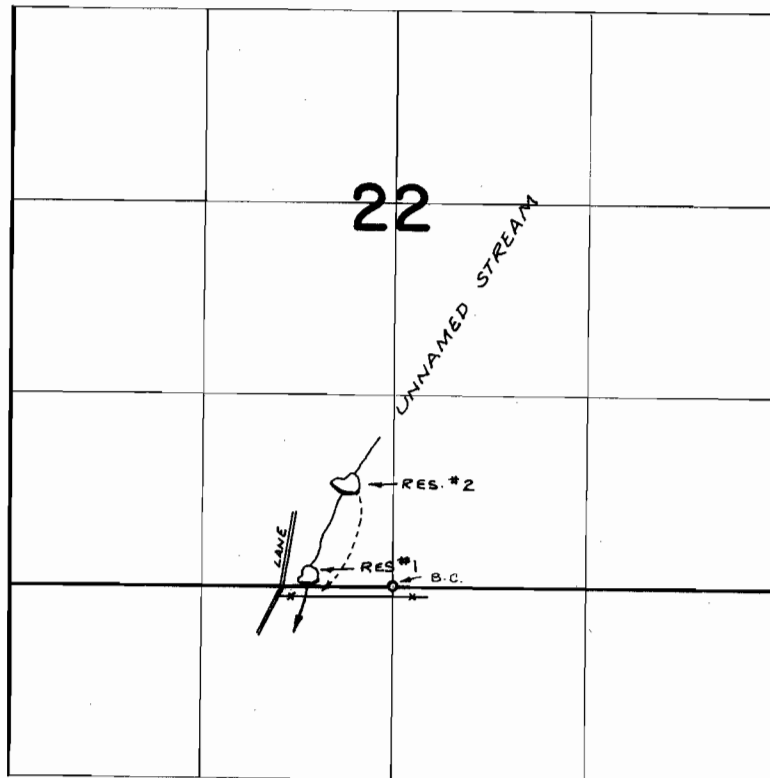

FINAL PROOF SURVEY
UNDER

Application No. R-48159 Permit No. R-5861
IN NAME OF


Surveyed JUNE 6, 1974, by R. MUCKEN