


T.19 S. R.11 W. W.M.

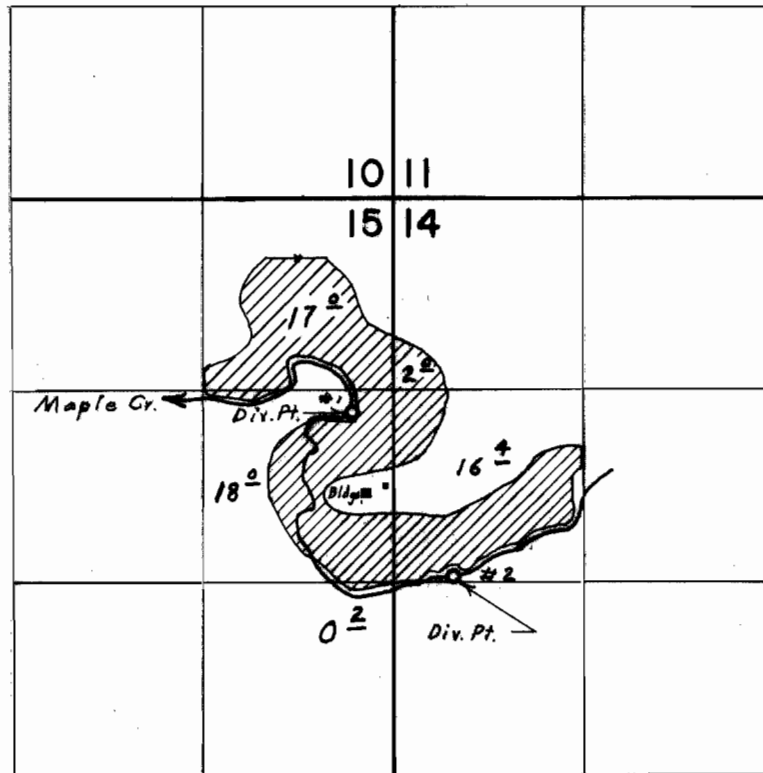

Div. Pts. loc.: #1, 1470' S. & 200' W.; #2, 2600' S. & 410' E.
both from N. E. Cor. Sec. 15

FINAL PROOF SURVEY
UNDER

Application No. 43671. Permit No. 32645.
IN NAME OF

PUBLISHERS PAPER CO.

Surveyed July 19, 1973, by L. E. Gould.